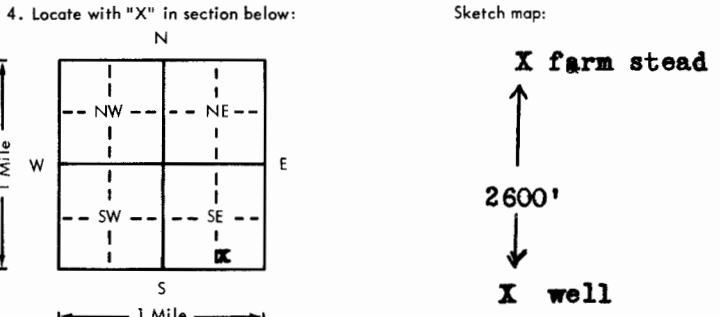


USE TYPEWRITER OR BALL
POINT PEN-PRESS FIRMLY,
PRINT CLEARLY.

WATER WELL RECORD
KSA 82a-1201-1215

Kansas Department of Health and
Environment-Division of Environment
(Water well Contractors)
Topeka, Kansas 66620

1. Location of well:	County Wichita	Fraction S/W 1/4 S/E 1/4 S/E 1/4	Section number 33	Township number 18	Range number 38
2. Distance and direction from nearest town or city: 1 1/2 S., 1 E., 1 S., 1/4 W. of Selkirk, KS	Street address of well location if in city:	3. Owner of well: R.R. or street: City, state, zip code: Glen Calhoun Leoti, Kansas 67861			
4. Locate with "X" in section below: 		Sketch map: X farm stead 2600' X well	6. Bore hole dia. 9 in. Completion date 10-5-1978 Well depth 125 ft.		
5. Type and color of material		From 0	To 18	7. <input type="checkbox"/> Cable tool <input checked="" type="checkbox"/> Rotary <input type="checkbox"/> Driven <input type="checkbox"/> Dug <input type="checkbox"/> Hollow rod <input type="checkbox"/> Jetted <input type="checkbox"/> Bored <input type="checkbox"/> Reverse rotary	
clay		18	21	8. Use: <input checked="" type="checkbox"/> Domestic <input type="checkbox"/> Public supply <input type="checkbox"/> Industry <input type="checkbox"/> Irrigation <input type="checkbox"/> Air conditioning <input type="checkbox"/> Stock <input type="checkbox"/> Lawn <input type="checkbox"/> Oil field water <input type="checkbox"/> Other	
gyp		21	26	9. Casing: Material Plastic <input type="checkbox"/> Right: Above or below Threaded <input type="checkbox"/> Welded Glue Surface 12 in. RMP X PVC 1.8 lbs./ft. Dia. 5 in. to 105 ft. depth Wall Thickness: inches or Dia. 5 in. to 105 ft. depth gage No. .250	
clay		26	29	10. Screen: Manufacturer's name Jess & Lowell Type RMP Dia. 5" Slot/gauze 1/16" Length 20' Set between 105 ft. and 125 ft. ft. and 125 ft. Gravel pack? yes Size range of material 1/8"	
gyp		29	34	11. Static water level: 98 ft. below land surface Date 9/27/78	
clay		34	42	12. Pumping level below land surfaces: 105 ft. after 1 hrs. pumping 10 g.p.m. 105 ft. after 1 hrs. pumping 10 g.p.m. Estimated maximum yield 10 g.p.m.	
sand coarse		42	51	13. Water sample submitted: yes Date 9/27/78	
rock H		51	59	14. Well head completion: X Pitless adapter 12 inches above grade	
clay		59	64	15. Well grouted? yes With: X Neat cement <input type="checkbox"/> Bentonite <input type="checkbox"/> Concrete Depth: From 0 ft. to 15 ft.	
sand coarse		64	70	16. Nearest source of possible contamination: 2600 ft. N Direction Farmstead Well disinfected upon completion? X Yes no	
sand rock H		70	80		
clay		80	94		
sandyy clay T		94	96		
sand rock H		96	102		
clay		102	105		
fine sand clay		105	108		
sand rock H		108	110		
clay		110	115		
fine sand clay		115	125		
yellow					
(Use a second sheet if needed)				17. Pump: <input type="checkbox"/> Not installed Manufacturer's name Red Jacket Model number N12BC HP 3/4 Volts 230 Length of drop pipe 120 ft. capacity 10 g.p.m. Type: X Submersible <input type="checkbox"/> Turbine <input type="checkbox"/> Jet <input type="checkbox"/> Reciprocating <input type="checkbox"/> Centrifugal <input type="checkbox"/> Other	
18. Elevation:	19. Remarks:	20. Water well contractor's certification: This well was drilled under my jurisdiction and this report is true to the best of my knowledge and belief. Weishaar Drilling & Sup. 232 Business name Scott City, KS 67871 License No. Address Scott City, KS 67871 Signed Glen Calhoun Date 10/10/78 Authorized representative			
Topography: <input type="checkbox"/> Hill <input type="checkbox"/> Slope X Upland <input type="checkbox"/> Valley					

Forward the white, blue and pink copies to the Department of Health and Environment

Form WWC-5