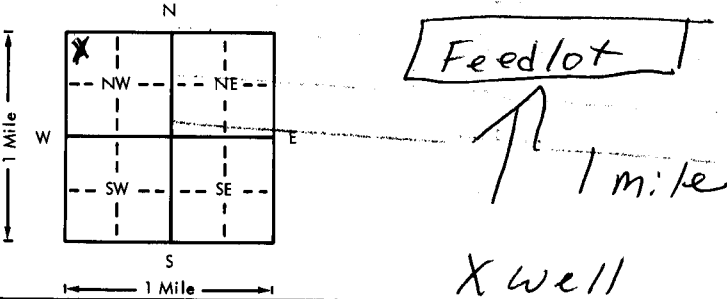


USE TYPEWRITER OR BALL
POINT PEN-PRESS FIRMLY,
PRINT CLEARLY.

WATER WELL RECORD
KSA 82a-1201-1215

Kansas Department of Health and
Environment-Division of Environment
(Water well Contractors)
Topeka, Kansas 66620

1. Location of well:		County Greeley	Fraction NW 1/4 NW 1/4 NW 1/4	Section number 18	Township number T 18 S R 39 E	Range number 39 E
2. Distance and direction from nearest town or city: 2N, 1/4 E of Street address of well location if in city: Whitelaw, Kansas				3. Owner of well: Robt. Brunswig R.R. or street: City, state, zip code: Tribune, KS 67879		
4. Locate with "X" in section below: 				6. Bore hole dia. <u>24</u> in. Completion date <u>8-28-76</u> Well depth <u>54</u> ft.		
5. Type and color of material				7. <input type="checkbox"/> Cable tool <input type="checkbox"/> Rotary <input type="checkbox"/> Driven <input type="checkbox"/> Dug <input type="checkbox"/> Hollow rod <input type="checkbox"/> Jetted <input type="checkbox"/> Bored <input checked="" type="checkbox"/> Reverse rotary		
				8. Use: <input type="checkbox"/> Domestic <input type="checkbox"/> Public supply <input type="checkbox"/> Industry <input checked="" type="checkbox"/> Irrigation <input type="checkbox"/> Air conditioning <input type="checkbox"/> Stock <input type="checkbox"/> Lawn <input type="checkbox"/> Oil field water <input type="checkbox"/> Other		
				9. Casing: Material <u>Steel</u> Height: <u>above</u> or below Threaded <input type="checkbox"/> Welded <input checked="" type="checkbox"/> Surface <u>10</u> in. RMP <input type="checkbox"/> PVC <input type="checkbox"/> Weight <u>17.5</u> lbs./ft. Dia. <u>12</u> in. to <u>54</u> ft. depth Wall Thickness: inches or Dia. <u> </u> in. to <u> </u> ft. depth gage No. <u>134</u>		
				10. Screen: Manufacturer's name <u>Johnson</u> Type <u>Galv. Steel</u> Dia. <u>12 in.</u> <input checked="" type="checkbox"/> slot gauze <u>100</u> Length <u>20 ft.</u> Set between <u>34</u> ft. and <u>54</u> ft. ft. and <u> </u> ft. Gravel pack? <u>yes</u> Size range of material <u>3/4-1/4</u>		
				11. Static water level: <u>36</u> ft. below land surface Date <u>8-28-76</u> mo./day/yr.		
				12. Pumping level below land surfaces: <u> </u> ft. after <u> </u> hrs. pumping <u>60</u> g.p.m. <u> </u> ft. after <u> </u> hrs. pumping <u> </u> g.p.m. Estimated maximum yield <u>60</u> g.p.m.		
				13. Water sample submitted: <u> </u> mo./day/yr. Yes <input checked="" type="checkbox"/> No <input type="checkbox"/> Date <u> </u>		
				14. Well head completion: <u> </u> Pitless adapter <u> </u> inches above grade		
				15. Well grouted? <u>yes</u> With: <input checked="" type="checkbox"/> Neat cement <input type="checkbox"/> Bentonite <input type="checkbox"/> Concrete Depth: From <u>0</u> ft. to <u>10</u> ft.		
				16. Nearest source of possible contamination: ft. <u>5280</u> Direction <u>North</u> Type <u>Feed Lot</u> Well disinfected upon completion? <input checked="" type="checkbox"/> Yes <input type="checkbox"/> No		
				17. Pump: <input checked="" type="checkbox"/> Not installed Manufacturer's name <u> </u> Model number <u> </u> HP <u> </u> Volts <u> </u> Length of drop pipe <u> </u> ft. capacity <u> </u> g.p.m. Type: <input type="checkbox"/> Submersible <input type="checkbox"/> Turbine <input type="checkbox"/> Jet <input type="checkbox"/> Reciprocating <input type="checkbox"/> Centrifugal <input type="checkbox"/> Other		
(Use a second sheet if needed)						
18. Elevation:		19. Remarks: Sorry that this is late in being reported, but did not know til recently that well was not to be completed by us.				
Topography: <input type="checkbox"/> Hill <input checked="" type="checkbox"/> Slope <input type="checkbox"/> Upland <input type="checkbox"/> Valley		20. Water well contractor's certification: This well was drilled under my jurisdiction and this report is true to the best of my knowledge and belief. Weishaar Drilling <u>232</u> Business name License No. Address <u>Route 2, KS 67871</u> State <u>KS</u> Date <u>8-18-77</u> Authorized representative				