WATER WELL RECORD Form WWC-5 KSA 82a-1212

1 LOCATION OF WATER WELL: County: Greeley | Fraction: NE ¼ SE ¼ NW ¼ | Section Number: 27 | Township Number: T 18 S | Range Number: R 39 E(W)

Distance and direction from nearest town or city street address of well if located within city?
7 East of Tribune, Ks

2 WATER WELL OWNER: Tribune Rendering Co.
RR#, St. Address, Box # :
City, State, ZIP Code : Tribune, KS 67879
Board of Agriculture, Division of Water Resources
Application Number: 25249

3 LOCATE WELL'S LOCATION WITH AN "X" IN SECTION BOX:

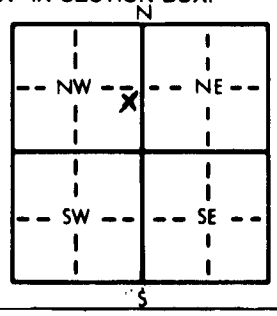


4 DEPTH OF COMPLETED WELL 176 ft. ELEVATION: 3620
Depth(s) Groundwater Encountered 1. 136 ft. 2. ft. 3. ft.
WELL'S STATIC WATER LEVEL 136 ft. below land surface measured on mo/day/yr 8-14-89
Pump test data: Well water was 141 ft. after 1 hours pumping 30 gpm
Est. Yield 60 gpm: Well water was 143 ft. after 2 hours pumping 45 gpm
Bore Hole Diameter 8 in. to 176 ft., and in. to ft.
WELL WATER TO BE USED AS: 5 Public water supply 8 Air conditioning 11 Injection well
1 Domestic 3 Feedlot 6 Oil field water supply 9 Dewatering 12 Other (Specify below)
2 Irrigation 4 Industrial 7 Lawn and garden only 10 Monitoring well
Was a chemical/bacteriological sample submitted to Department? Yes No X; If yes, mo/day/yr sample was submitted
Water Well Disinfected? Yes X No

5 TYPE OF BLANK CASING USED: 5 Wrought iron 8 Concrete tile CASING JOINTS: Glued X Clamped
1 Steel 3 RMP (SR) 6 Asbestos-Cement 9 Other (specify below) Welded
2 PVC 4 ABS 7 Fiberglass Threaded
Blank casing diameter 5 in. to 136 ft., Dia in. to ft., Dia in. to ft.
Casing height above land surface 24 in., weight lbs./ft. Wall thickness or gauge No. SCH 200

TYPE OF SCREEN OR PERFORATION MATERIAL: 7 PVC 10 Asbestos-cement
1 Steel 3 Stainless steel 5 Fiberglass 8 RMP (SR) 11 Other (specify)
2 Brass 4 Galvanized steel 6 Concrete tile 9 ABS 12 None used (open hole)

SCREEN OR PERFORATION OPENINGS ARE: 5 Gauzed wrapped 8 Saw cut 11 None (open hole)
1 Continuous slot 3 Mill slot 6 Wire wrapped 9 Drilled holes
2 Louvered shutter 4 Key punched 7 Torch cut 10 Other (specify)

SCREEN-PERFORATED INTERVALS: From 136 ft. to 176 ft., From ft. to ft.
From ft. to ft., From ft. to ft.
GRAVEL PACK INTERVALS: From 100 ft. to 176 ft., From ft. to ft.
From ft. to ft., From ft. to ft.

6 GROUT MATERIAL: 1 Neat cement 2 Cement grout 3 Bentonite 4 Other
Grout Intervals: From 0 ft. to 100 ft., From ft. to ft., From ft. to ft.

What is the nearest source of possible contamination:
1 Septic tank 4 Lateral lines 7 Pit privy 10 Livestock pens 14 Abandoned water well
2 Sewer lines 5 Cess pool 8 Sewage lagoon 11 Fuel storage 15 Oil well/Gas well
3 Watertight sewer lines 6 Seepage pit 9 Feedyard 12 Fertilizer storage 16 Other (specify below)
13 Insecticide storage
Direction from well? West How many feet? 750 ft

| FROM | TO | LITHOLOGIC LOG | FROM | TO | PLUGGING INTERVALS |
|---|---|---|---|---|---|
| 0 | 5 | top soil | 172 | 176 | shale |
| 5 | 16 | limestone | | | |
| 16 | 49 | limestone & little sand | | | |
| 49 | 66 | limestone & clay & sand | | | |
| 66 | 82 | limestone & sand | | | |
| 82 | 90 | sand (fine) | | | |
| 90 | 91 | cemented sand (hard) | | | |
| 91 | 99 | clay | | | |
| 99 | 115 | sand (medium) & little clay | | | |
| 115 | 136 | sand (fine) | | | |
| 136 | 141 | clay | | | |
| 141 | 145 | gravel (medium) | | | |
| 145- | 148 | cemented sand & limestone (hard) | | | |
| 148 | 165 | cemented sand & limestone (very very Hard) | | | |
| 165 | 172 | clay | | | |

7 CONTRACTOR'S OR LANDOWNER'S CERTIFICATION: This water well was (1) constructed, (2) reconstructed, or (3) plugged under my jurisdiction and was completed on (mo/day/year) 8-30-89 and this record is true to the best of my knowledge and belief. Kansas Water Well Contractor's License No. 473 This Water Well Record was completed on (mo/day/yr) 9-10-89
under the business name of Tyler Water Well Service by (signature) Ted Tyler

INSTRUCTIONS: Use typewriter or ball point pen. *PLEASE PRESS FIRMLY* and *PRINT* clearly. Please fill in blanks, underline or circle the correct answers. Send top three copies to Kansas Department of Health and Environment, Bureau of Water Protection, Topeka, Kansas 66620-7320. Telephone: 913-296-5514. Send one to WATER WELL OWNER and retain one for your records.

OFFICE USE ONLY T R E/W SEC. ¼ ¼ ¼