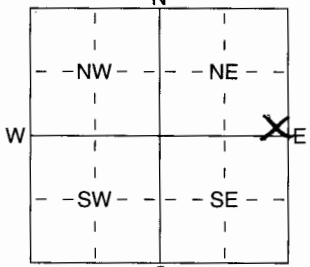


1 LOCATION OF WATER WELL: Fraction Se 1/4 Se 1/4 me 1/4 Section Number 26 Township Number T 12 S Range Number R 4 E
 County: Mpherson

Distance and direction from nearest town or city street address of well if located within city?
5 1/2 N 3 W Mpherson

2 WATER WELL OWNER: Donald Bland
 RR#, St. Address, Box #: 1953 11th Ave Board of Agriculture, Division of Water Resources
 City, State, ZIP Code: Mpherson, KS, 67460 Application Number:

3 LOCATE WELL'S LOCATION WITH AN "X" IN SECTION BOX:

 4 DEPTH OF COMPLETED WELL: 140 ft. ELEVATION:
 Depth(s) Groundwater Encountered: 1 100 ft. 2 ft. 3 ft.
 WELL'S STATIC WATER LEVEL: 92 ft. below land surface measured on mo/day/yr 6-30-04
 Pump test data: Well water was ft. after hours pumping gpm
 Est. Yield: 25 gpm. Well water was ft. after hours pumping gpm
 WELL WATER TO BE USED AS:
 1 Domestic 3 Feedlot 6 Oil field water supply 9 Dewatering 12 Other (Specify below)
 2 Irrigation 4 Industrial 7 Domestic (lawn & garden) 10 Monitoring well
 Was a chemical/bacteriological sample submitted to Department? Yes No; If yes, mo/day/yr sample was submitted
 Water Well Disinfected? Yes No

5 TYPE OF BLANK CASING USED:
 1 Steel 3 RMP (SR) 5 Wrought iron 8 Concrete tile CASING JOINTS: Glued X Clamped
 2 PVC 4 ABS 6 Asbestos-Cement 9 Other (specify below) Welded
 7 Fiberglass Threaded
 Blank casing diameter: 5 in. to 120 ft. Dia. in. to ft. Dia. in. to ft.
 Casing height above land surface: 12 in., weight CLASS 160 lbs./ft. Wall thickness or gauge No. 214
 TYPE OF SCREEN OR PERFORATION MATERIAL:
 1 Steel 3 Stainless Steel 5 Fiberglass 7 PVC 10 Asbestos-Cement
 2 Brass 4 Galvanized Steel 6 Concrete tile 8 RMP (SR) 11 Other (Specify)
 9 ABS 12 None used (open hole)
 SCREEN OR PERFORATION OPENINGS ARE:
 1 Continuous slot 3 Mill slot 5 Gauzed wrapped 8 Saw cut 11 None (open hole)
 2 Louvered shutter 4 Key punched 7 Torch cut 9 Drilled holes
 10 Other (specify) ft.
 SCREEN-PERFORATED INTERVALS: From 120 ft. to 140 ft. From ft. to ft.
 GRAVEL PACK INTERVALS: From ft. to ft. From ft. to ft.

6 GROUT MATERIAL: 1 Neat cement 2 Cement grout 3 Bentonite 4 Other
 Grout Intervals: From 0 ft. to 20 ft. From ft. to ft. From ft. to ft.
 What is the nearest source of possible contamination:
 1 Septic tank 4 Lateral lines 7 Pit privy 10 Livestock pens 14 Abandoned water well
 2 Sewer lines 5 Cess pool 8 Sewage lagoon 11 Fuel storage 15 Oil well/Gas well
 3 Watertight sewer lines 6 Seepage pit 9 Feedyard 12 Fertilizer storage 16 Other (specify below)
 13 Insecticide storage
 Direction from well? SW How many feet? 100 +

FROM	TO	LITHOLOGIC LOG	FROM	TO	PLUGGING INTERVALS
<u>0</u>	<u>100</u>	<u>yellow + Red Clay</u>			
<u>100</u>	<u>137</u>	<u>medium Sand + Water</u>			
<u>137</u>	<u>140</u>	<u>Red Clay</u>			
					RECEIVED
					AUG 25 2004
					BUREAU OF WATER

7 CONTRACTOR'S OR LANDOWNER'S CERTIFICATION: This water well was (1) constructed, (2) reconstructed, or (3) plugged under my jurisdiction and was completed on (mo/day/year) 6-30-04 and this record is true to the best of my knowledge and belief. Kansas Water Well Contractor's Licence No. 100 This Water Well Record was completed on (mo/day/yr) 7-5-04 under the business name of Backhu Drilling by (signature) Paul H. Backhu