


1 LOCATION OF WATER WELL: Fraction NW 1/4 NW 1/4 NW 1/4 Section Number 3 Township Number T 18 S Range Number R 4

County: McPherson Distance and direction from nearest town or city street address of well if located within city?

3 miles South & 4 miles West of Lindsborg, KS

2 WATER WELL OWNER: Kent Rawson RR#, St. Address, Box #: Rt 2 City, State, ZIP Code: Lindsborg, KS 67456 Board of Agriculture, Division of Water Resources Application Number:

3 LOCATE WELL'S LOCATION WITH AN "X" IN SECTION BOX: 4 DEPTH OF COMPLETED WELL: 4.7 ft. ELEVATION:

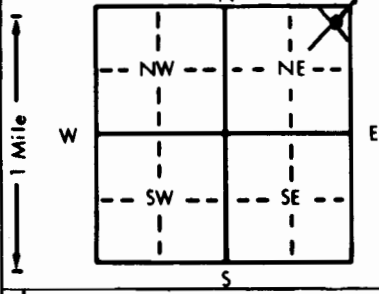

Depth(s) Groundwater Encountered 1. 1.8 ft. 2. ft. 3. ft. WELL'S STATIC WATER LEVEL . . . . . 1.8 . . ft. below land surface measured on mo/day/yr 1.2-28-93 . . . . . Pump test data: Well water was . . . . . ft. after . . . . . hours pumping . . . . . gpm Est. Yield . 5-8 . . gpm: Well water was . . . . . 32 . . ft. after . . . . . 1 . . . . . hours pumping . . . . . 8 . . . . . gpm Bore Hole Diameter . . . . . 8 . . . . . in. to . . . . . 50 . . . . . ft., and . . . . . in. to . . . . . ft. WELL WATER TO BE USED AS: 5 Public water supply 8 Air conditioning 11 Injection well 1 Domestic 3 Feedlot 6 Oil field water supply 9 Dewatering 12 Other (Specify below) 2 Irrigation 4 Industrial 7 Lawn and garden only 10 Monitoring well . . . . . Stock . . . . . Was a chemical/bacteriological sample submitted to Department? Yes . . . . . No. X . . . . . ; If yes, mo/day/yr sample was submitted Water Well Disinfected? Yes X No

5 TYPE OF BLANK CASING USED: 1 Steel 3 RMP (SR) 5 Wrought iron 8 Concrete tile CASING JOINTS: Glued X Clamped Welded 2 PVC 4 ABS 7 Fiberglass 9 Other (specify below) Threaded

Blank casing diameter . . . . . 5 . . . . . in. to . . . . . 37 . . . . . ft., Dia . . . . . in. to . . . . . ft., Dia . . . . . in. to . . . . . ft. Casing height above land surface . . . . . 1.2 . . . . . in., weight . . . . . 2.37 . . . . . lbs./ft. Wall thickness or gauge No. . . . . 2.1.4 . . . . .

TYPE OF SCREEN OR PERFORATION MATERIAL: 1 Steel 3 Stainless steel 5 Fiberglass 7 PVC 10 Asbestos-cement 2 Brass 4 Galvanized steel 6 Concrete tile 8 RMP (SR) 11 Other (specify) 12 None used (open hole)

SCREEN OR PERFORATION OPENINGS ARE: 1 Continuous slot 3 Mill slot 5 Gauzed wrapped 8 Saw cut 11 None (open hole) 2 Louvered shutter 4 Key punched 6 Wire wrapped 9 Drilled holes 7 Torch cut 10 Other (specify)

SCREEN-PERFORATED INTERVALS: From . . . . . 37 . . . . . ft. to . . . . . 47 . . . . . ft., From . . . . . ft. to . . . . . ft. GRAVEL PACK INTERVALS: From . . . . . 25 . . . . . ft. to . . . . . 47 . . . . . ft., From . . . . . ft. to . . . . . ft.

6 GROUT MATERIAL: 1 Neat cement 2 Cement grout 3 Bentonite 4 Other Grout Intervals: From . . . . . 5 . . . . . ft. to . . . . . 25 . . . . . ft., From . . . . . ft. to . . . . . ft., From . . . . . ft. to . . . . . ft.

What is the nearest source of possible contamination: 1 Septic tank 4 Lateral lines 7 Pit privy 10 Livestock pens 14 Abandoned water well 2 Sewer lines 5 Cess pool 8 Sewage lagoon 11 Fuel storage 15 Oil well/Gas well 3 Watertight sewer lines 6 Seepage pit 9 Feedyard 12 Fertilizer storage 16 Other (specify below) 13 Insecticide storage

Direction from well? EAST How many feet? 75 ft

FROM	TO	LITHOLOGIC LOG	FROM	TO	PLUGGING INTERVALS
0	2	Top Soil			
2	17	Gray Clay			
17	35	Gray Shale			
35	38	Soft Gray Shale			
38	50	Gray & Red Shale			

7 CONTRACTOR'S OR LANDOWNER'S CERTIFICATION: This water well was (1) constructed, (2) reconstructed, or (3) plugged under my jurisdiction and was completed on (mo/day/year) 12-28-93 and this record is true to the best of my knowledge and belief. Kansas Water Well Contractor's License No. 1.38 This Water Well Record was completed on (mo/day/yr) 1-6-93 under the business name of Peterson Irrigation Inc. by (signature) Mike Peterson