


1 LOCATION OF WATER WELL: County: McPherson Fraction: SW 1/4 NW 1/4 NW 1/4 Section Number: 4 Township Number: T 18 S Range Number: R 4 W

Distance and direction from nearest town or city street address of well if located within city?
2 miles South & 3 miles East of Marquette, KS

2 WATER WELL OWNER: Bob Edwards
 RR#, St. Address, Box #: RR 1 Board of Agriculture, Division of Water Resources
 City, State, ZIP Code: Marquette, KS 67464 Application Number:

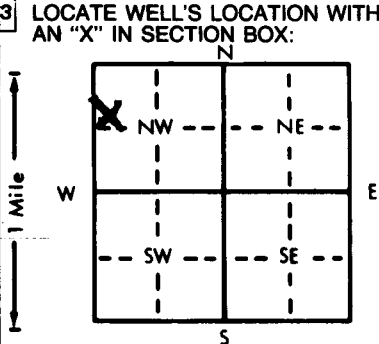

4 DEPTH OF COMPLETED WELL: 71 ft. ELEVATION:
 Depth(s) Groundwater Encountered 1. 28 ft. 2. ft. 3. ft.
 WELL'S STATIC WATER LEVEL . . . 28 ft. below land surface measured on mo/day/yr 5-31-89 - 6-1-89
 Pump test data: Well water was ft. after hours pumping gpm
 Est. Yield 15-20 gpm: Well water was ft. after hours pumping gpm
 Bore Hole Diameter: . . . 8 in. to . . . 7.5 ft., and in. to ft.
 WELL WATER TO BE USED AS: 5 Public water supply 8 Air conditioning 11 Injection well
 1 Domestic 3 Feedlot 6 Oil field water supply 9 Dewatering 12 Other (Specify below)
 2 Irrigation 4 Industrial 7 Lawn and garden only 10 Monitoring well
 Was a chemical/bacteriological sample submitted to Department? Yes No X; If yes, mo/day/yr sample was submitted
 Water Well Disinfected? Yes X No

5 TYPE OF BLANK CASING USED: 5 Wrought iron 8 Concrete tile CASING JOINTS: Glued Clamped
 1 Steel 3 RMP (SR) 6 Asbestos-Cement 9 Other (specify below) Welded
 2 PVC 4 ABS 7 Fiberglass Threaded
 Blank casing diameter . . . 5 in. to . . . 3.7 ft., Dia 4.6 ft. to . . . 6.6 ft., Dia in. to ft.
 Casing height above land surface . . . 12 in., weight 2.91 lbs./ft. Wall thickness or gauge No. 265
 TYPE OF SCREEN OR PERFORATION MATERIAL: 7 PVC 10 Asbestos-cement
 1 Steel 3 Stainless steel 5 Fiberglass 8 RMP (SR) 11 Other (specify)
 2 Brass 4 Galvanized steel 6 Concrete tile 9 ABS 12 None used (open hole)
 SCREEN OR PERFORATION OPENINGS ARE: 5 Gauzed wrapped 8 Saw cut 11 None (open hole)
 1 Continuous slot 3 Mill slot 6 Wire wrapped 9 Drilled holes
 2 Louvered shutter 4 Key punched 7 Torch cut 10 Other (specify)
 SCREEN-PERFORATED INTERVALS: From . . . 3.7 ft. to . . . 4.6 ft., From ft. to ft.
 From . . . 6.6 ft. to . . . 7.1 ft., From ft. to ft.
 GRAVEL PACK INTERVALS: From . . . 2.5 ft. to . . . 7.1 ft., From ft. to ft.
 From ft. to ft., From ft. to ft.

6 GROUT MATERIAL: 1 Neat cement 2 Cement grout 3 Bentonite 4 Other
 Grout intervals: From . . . 5 ft. to . . . 2.5 ft., From ft. to ft., From ft. to ft.
 What is the nearest source of possible contamination:
 1 Septic tank 4 Lateral lines 7 Pit privy 10 Livestock pens 14 Abandoned water well
 2 Sewer lines 5 Cess pool 8 Sewage lagoon 11 Fuel storage 15 Oil well/Gas well
 3 Watertight sewer lines 6 Seepage pit 9 Feedyard 12 Fertilizer storage 16 Other (specify below)
 13 Insecticide storage
 Direction from well? South How many feet? 50

FROM	TO	LITHOLOGIC LOG	FROM	TO	PLUGGING INTERVALS
0	1	Top Soil			
1	17	Red Shale			
17	39	Gray Shale			
39	41	Cavity--Water Zone			
41	42	Mica			
42	52	Red Shale			
52	75	Gray and Red Shale			

7 CONTRACTOR'S OR LANDOWNER'S CERTIFICATION: This water well was (1) constructed, (2) reconstructed, or (3) plugged under my jurisdiction and was completed on (mo/day/year) 6-1-89 and this record is true to the best of my knowledge and belief. Kansas Water Well Contractor's License No. 138 This Water Well Record was completed on (mo/day/yr) 6-3-89 under the business name of Peterson Irrigation, Inc. by (signature) Mike Peterson