USE TYPEWRITER OR BALL POINT PEN-PRESS FIRMLY, PRINT CLEARLY.

WATER WELL RECORD
KSA 82a-1201-1215

Kansas Department of Health and Environment-Division of Environment
(Water well Contractors)
Topeka, Kansas 66620

1. Location of well:	County	Fraction	Section number	Township number	Range number
	McPherson	SE 1/4 NE 1/4 NE 1/4	13	T 18 S	R 4 ~~E~~ W

2. Distance and direction from nearest town or city: 5 mi S AND 2 W OF LINDSBORG, KS
Street address of well location if in city:

3. Owner of well: CHUCK ORR
R.R. or street: 501 N. WALNUT
City, state, zip code: McPherson, Ks. 67460

4. Locate with "X" in section below: Sketch map:

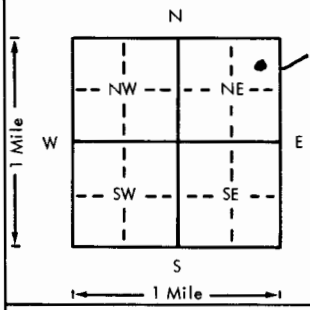

6. Bore hole dia. 18 in. Completion date
Well depth 95 ft. 8-29-78

7. __ Cable tool X Rotary __ Driven __ Dug
__ Hollow rod __ Jetted __ Bored __ Reverse rotary

8. Use: X Domestic __ Public supply __ Industry
__ Irrigation __ Air conditioning __ Stock
__ Lawn __ Oil field water __ Other

9. Casing: Material
Threaded ___ Welded ___
RMP ___ PVC X
Dia. 4 in. to 85 ft. depth
Dia. ___ in. to ___ ft. depth
Height: (Above) or below
Surface 12 in.
Weight 2 lbs./ft.
Wall Thickness: inches or gage No. .25 in.

5. Type and color of material	From	To
Top soils	0	5
Buff clay	5	45
Gray + Buff clay	45	65
Gray clay	65	80
Med. light gray sand + some clay	80	95
layers		

(Use a second sheet if needed)

10. Screen: Manufacturer's name Peerless Plastics
Type PVC Dia. 4"
Slot/gauze 1/16 Length 10'
Set between 85 ft. and 95 ft.
___ ft. and ___ ft.
Gravel pack? Yes Size range of material 1/4-1/4

11. Static water level: mo./day/yr.
48 ft. below land surface Date 8-29-78

12. Pumping level below land surfaces:
44 ft. after 1½ hrs. pumping 6-15 g.p.m.
___ ft. after ___ hrs. pumping ___ g.p.m.
Estimated maximum yield 20 g.p.m.

13. Water sample submitted: mo./day/yr.
__ Yes X No Date

14. Well head completion:
__ Pitless adapter 12 Inches above grade

15. Well grouted? Yes
With: X Neat cement ___ Bentonite ___ Concrete
Depth: From 4 ft. to 14 ft.

16. Nearest source of possible contamination:
ft. 1500 Direction W Type Cattle
Well disinfected upon completion? X Yes ___ No

17. Pump: X Not installed
Manufacturer's name
Model number ___ HP ___ Volts ___
Length of drop pipe ___ ft. capacity ___ g.p.m.
Type:
__ Submersible __ Turbine
__ Jet __ Reciprocating
__ Centrifugal __ Other

T 18 R 4 E (W) Sec 13 1/4 SE 1/4 NE 1/4 NE 1/4

18. Elevation:
Topography:
__ Hill
__ Slope
__ Upland
X Valley

19. Remarks:

20. Water well contractor's certification:
This well was drilled under my jurisdiction and this report is true to the best of my knowledge and belief.
Peterson Irrigation 138
Business name License No.
Address Box 150 Lindsborg, Ks.
Signed Mike Peterson Date 9-8-78
Authorized representative

Forward the white, blue and pink copies to the Department of Health and Environment

Form WWC-5