2

USE TYPEWRITER OR BALL POINT PEN-PRESS FIRMLY, PRINT CLEARLY.

T R EW sec 1/4 1/4 1/4 No.

WATER WELL RECORD
KSA 82a-1201-1215

Kansas State Dept. Of Health
(Water Well Contractors)
Forbes-Bldg. 740
Topeka, Kansas 66620

1 Location of well:	County	Township name	Fraction	Section number	Town number	Range number
	McPherson	Harper	SE¼ SE¼ SW¼	15	18-S	4-W

Distance and direction from nearest town or city: 4 mi West & mi North ½ mi East of McPherson
Street address of well location if in city:

3 Owner of well: Ada Larson
Address: R.R. 3 McPherson Ks.

Locate with "X" in section below:

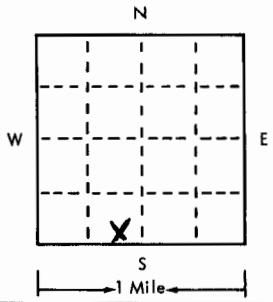

Sketch map:

CDD

4 Well depth: 100 ft. Date of completion 6-4-75
Well diameter 9 in.

5 ☐ Cable tool ☒ Rotary ☐ Driven ☐ Dug
☐ Hollow rod ☐ Jetted ☐ Bored ☐ Reverse rotary

6 Use: ☒ Domestic ☐ Public supply ☐ Industry
☐ Irrigation ☐ Air conditioning ☐ Commercial
☐ Test well ☐

7 Casing: Plastic Height: above/below
Threaded ☐ Welded ☐ Surface 12 in.
Diam. Class Weight 160 lbs./ft.
5 in. to 100 ft. depth Drive shoe? ☐ Yes ☒ No
___ in. to ___ ft. depth

8 Screen:
Manufacturer Certain-Teed
Type Plastic Dia. 5
Slot/gauze 76 Length 10 ft
Set between 85 ft. and 95 ft.
Fittings:
Gravel pack ☒ Yes ☐ No Size range of material ¼ to ¾ in

9 Static water level:
80 ft. below land surface Date 6-4-75

10 Pumping level below land surfaces:
___ ft. after ___ hrs. pumping ___ g.p.m.
___ ft. after ___ hrs. pumping ___ g.p.m.
Estimated maximum yield ___ g.p.m.

11 Water sample submitted:
☐ Yes ☒ No Date ___

12 Well head completion:
☐ Pitless adapter ☐ Inches above grade

13 Well grouted? ☒ Yes ☐ No
☒ Neat cement ☐ Bentonite ☐
Depth: From 3 ft. to 15 ft.

14 Nearest source of possible contamination: Cattle
ft. 75 Direction North Type corral
Well disinfected upon completion? ☒ Yes ☐ No

15 Pump: ☒ Not installed
Manufacturer's name
Model number HP Volts
Length of drop pipe ft. capacity g.m.p.
Type:
☐ Submersible ☐ Turbine
☐ Jet ☐ Reciprocating
☐ Certrifugal ☐ Other

2 Type and color of material	From	To
Top Soil	0	4
Yellow Clay	4	35
fine Sand & Silacone dry	35	65
medium Gravel	65	75
Gray Clay	75	80
Medium to course gravel	80	95
Yellow & Gray Shale	95	100

(use a second sheet if needed)

16 Remarks: elevation

Topography:
☒ Hill
☐ Slope
☐ Upland
☐ Valley

17 Water well contractor's certification:
This well was drilled under my jurisdiction and this report is true to the best of my knowledge and belief.
Bachus Drilling 180
Business name License No.
Address Lamar Kan
Signed Paul Bachus Date 6-15-75
Authorized representative

Forward the white, blue and pink copies to the Kansas State Dept. Of Health.

Form WWC-5