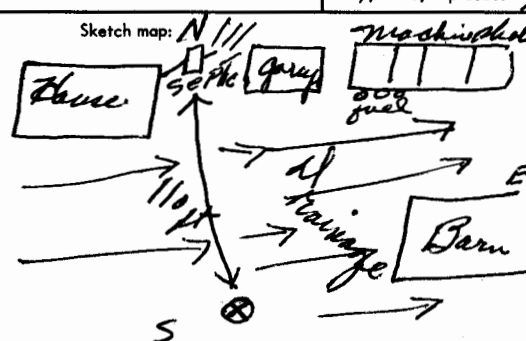


USE TYPEWRITER OR BALL POINT PEN—PRESS FIRMLY, PRINT CLEARLY.

WATER WELL RECORD
KSA 82a-1201-1215

Kansas Department of Health and Environment—Division of Environment (Water well Contractors)
Topeka, Kansas 66620

1. Location of well: County <u>McPherson</u> Fraction <u>N 1/4 N 1/4 N 1/4</u> Section number <u>21</u> Township number <u>T 18 S R 4</u> Range number <u>4 E M</u>	
2. Distance and direction from nearest town or city: <u>6 W - 6 S.</u> Street address of well location if in city: <u>Lindsborg, Kansas</u>	
3. Owner of well: <u>Dean Johnson</u> R.R. or street: <u>R.R. 1</u> City, state, zip code: <u>Marquette, Kansas 67464</u>	
4. Locate with "X" in section below: Sketch map: 	
6. Bore hole dia. <u>8</u> in. Completion date <u>11-5-75</u> Well depth <u>45</u> ft.	
7. <input checked="" type="checkbox"/> Cable tool <input checked="" type="checkbox"/> Rotary <input type="checkbox"/> Driven <input type="checkbox"/> Dug <input type="checkbox"/> Hollow rod <input type="checkbox"/> Jetted <input type="checkbox"/> Bored <input type="checkbox"/> Reverse rotary	
8. Use: <input checked="" type="checkbox"/> Domestic <input type="checkbox"/> Public supply <input type="checkbox"/> Industry <input type="checkbox"/> Irrigation <input type="checkbox"/> Air conditioning <input type="checkbox"/> Stock <input type="checkbox"/> Lawn <input type="checkbox"/> Oil field water <input type="checkbox"/> Other	
9. Casing: Material <u>PLTS</u> Height: <u>Above</u> or below Threading: <u>Welded</u> Surface <u>24"</u> in. RMP: <u>PVC</u> Weight <u>7.5</u> lbs./ft. Dia. <u>5</u> in. to <u>47</u> ft. depth Wall Thickness: inches or Dia. <u>—</u> in. to <u>—</u> ft. depth gage No. <u>41-5</u>	
10. Screen: Manufacturer's name <u>Get Screen</u> Type <u>P.V.C.</u> Dia. <u>5"</u> Slope gauze <u>7/16</u> Length <u>10'</u> Set between <u>45</u> ft. and <u>35</u> ft. Gravel pack? <u>Yes</u> Size range of material <u>41-49</u>	
11. Static water level: <u>18</u> ft. below land surface Date <u>11-5-75</u>	
12. Pumping level below land surfaces: <u>19</u> ft. after <u>2</u> hrs. pumping <u>7-15</u> g.p.m. Estimated maximum yield <u>40</u> g.p.m.	
13. Water sample submitted: <u>Yes</u> <input checked="" type="checkbox"/> No <input type="checkbox"/> Date <u>—</u>	
14. Well head completion: <u>Pump House</u> Pitless adapter <u>24</u> inches above grade	
15. Well grouted? <u>Yes</u> With: <input checked="" type="checkbox"/> Neat cement <input type="checkbox"/> Bentonite <input type="checkbox"/> Concrete Depth: From <u>0</u> ft. to <u>10</u> ft.	
16. Nearest source of possible contamination: ft. <u>110</u> Direction <u>N.W.</u> Type <u>Septic</u> Well disinfected upon completion? <input checked="" type="checkbox"/> Yes <input type="checkbox"/> No	
17. Pump: <u>Not installed</u> Manufacturer's name <u>Meyer</u> Model number <u>22832</u> HP <u>42</u> Volts <u>230</u> Length of drop pipe <u>40</u> ft. capacity <u>10</u> g.p.m. Type: <input checked="" type="checkbox"/> Submersible <input type="checkbox"/> Turbine <input type="checkbox"/> Jet <input type="checkbox"/> Reciprocating <input type="checkbox"/> Centrifugal <input type="checkbox"/> Other	
(Use a second sheet if needed)	
18. Elevation: Topography: <input type="checkbox"/> Hill <input type="checkbox"/> Slope <input checked="" type="checkbox"/> Upland <input type="checkbox"/> Valley	19. Remarks: <u>Mr. Johnson will pour slab for pump house.</u>
20. Water well contractor's certification: This well was drilled under my jurisdiction and this report is true to the best of my knowledge and belief. <u>Peterson Bros Inc</u> Business name <u>138</u> License No. Address <u>Box 150 Lindsborg Kan</u> Signed <u>Wally Peterson</u> Date <u>11-5-75</u> Authorized representative	

T 18 S R 4 E M 21 1/4 1/4 1/4