Darling Drilling Co.

Residence Phone 662-3991

1211 W. 4th
Hutchinson, Kansas 67501

Office Phone 662-7901

DRILLER'S TEST LOG

Customer's Name: Steve Fisher Date: 9-22-79

Address: Windom Test No.: Home well

County: McPherson Quarter: SW/SW/SW Section: 20 Township: 18 Range: 4W

DRILLED FOOTAGE From	To	DESCRIPTION OF STRATA
0	3	T.S.
3	33	Brown Clay
33	34	Sandy Streak
34	48	Brown Clay
48	49	Sandy streak
49	—	Shale

Indicate Test Location By an X

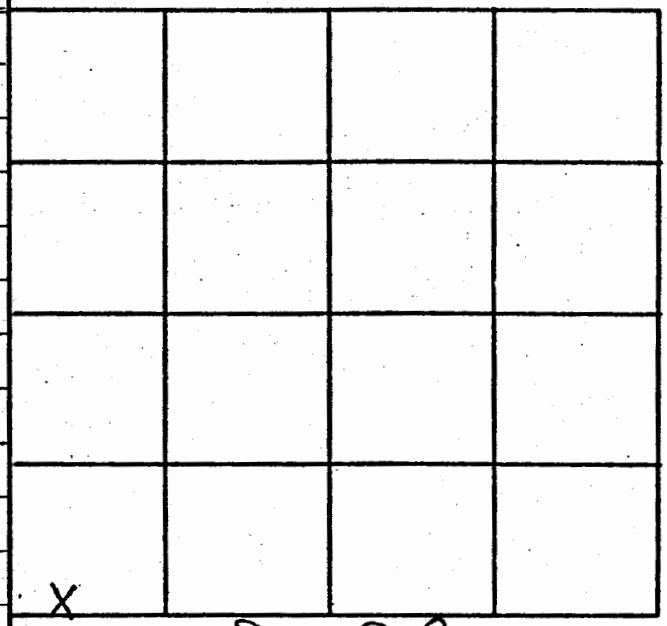

Static Water Level: Dry Hole

REMARKS: