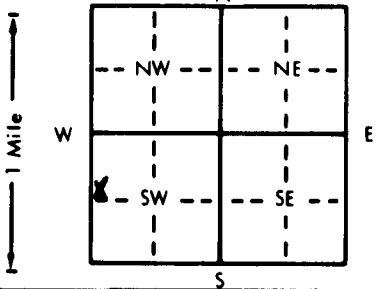


1 LOCATION OF WATER WELL: County: Greeley		Fraction SW 1/4 NW 1/4 SW 1/4		Section Number 4		Township Number T 18 S		Range Number R 40 E/W	
Distance and direction from nearest town or city street address of well if located within city? 3 Miles North and 1/2 Mile East of Tribune									
2 WATER WELL OWNER: City of Tribune RR#, St. Address, Box #: 412 Broadway City, State, ZIP Code: Tribune, KS 67879 Board of Agriculture, Division of Water Resources Application Number:									
3 LOCATE WELL'S LOCATION WITH AN "X" IN SECTION BOX: <div style="text-align:center"></div>			4 DEPTH OF COMPLETED WELL: 178 ft. ELEVATION: Depth(s) Groundwater Encountered 1. ft. 2. ft. 3. ft. WELL'S STATIC WATER LEVEL: 130 ft. below land surface measured on mo/day/yr Pump test data: Well water was 165 ft. after 5 hours pumping 220 gpm Est. Yield gpm: Well water was ft. after hours pumping gpm Bore Hole Diameter: 26 in. to 178 ft. and in. to ft. WELL WATER TO BE USED AS: 5 Public water supply 8 Air conditioning 11 Injection well 1 Domestic 3 Feedlot 6 Oil field water supply 9 Dewatering 12 Other (Specify below) 2 Irrigation 4 Industrial 7 Lawn and garden only 10 Monitoring well Was a chemical/bacteriological sample submitted to Department? Yes No <input checked="" type="checkbox"/> If yes, mo/day/yr sample was submitted Water Well Disinfected? Yes <input checked="" type="checkbox"/> No						
5 TYPE OF BLANK CASING USED: 1 Steel 3 RMP (SR) 5 Wrought iron 8 Concrete tile CASING JOINTS: Glued Clamped 2 PVC 4 ABS 6 Asbestos-Cement 9 Other (specify below) Welded <input checked="" type="checkbox"/> Blank casing diameter 12-3/4 in. to 153 ft., Dia in. to ft., Dia in. to ft. Casing height above land surface: 24 in., weight lbs./ft. Wall thickness or gauge No. 322 TYPE OF SCREEN OR PERFORATION MATERIAL: 1 Steel 3 Stainless steel 5 Fiberglass 7 PVC 10 Asbestos-cement 2 Brass 4 Galvanized steel 6 Concrete tile 8 RMP (SR) 11 Other (specify) 12 None used (open hole) SCREEN OR PERFORATION OPENINGS ARE: 1 Continuous slot 3 Mill slot 5 Gauzed wrapped 8 Saw cut 11 None (open hole) 2 Louvered shutter 4 Key punched 6 Wire wrapped 9 Drilled holes SCREEN-PERFORATED INTERVALS: From 178 ft. to 153 ft., From ft. to ft. GRAVEL PACK INTERVALS: From 178 ft. to 20 ft., From ft. to ft. From ft. to ft., From ft. to ft.									
6 GROUT MATERIAL: 1 Neat cement 2 Cement grout 3 Bentonite 4 Other Grout Intervals: From 0 ft. to 20 ft., From ft. to ft., From ft. to ft. What is the nearest source of possible contamination: 1 Septic tank 4 Lateral lines 7 Pit privy 10 Livestock pens 14 Abandoned water well 2 Sewer lines 5 Cess pool 8 Sewage lagoon 11 Fuel storage 15 Oil well/Gas well 3 Watertight sewer lines 6 Seepage pit 9 Feedyard 12 Fertilizer storage 16 Other (specify below) 13 Insecticide storage Direction from well? How many feet? FROM TO LITHOLOGIC LOG FROM TO PLUGGING INTERVALS 0 2 Top Soil 124 141 Coarse Sand, Small to Medium 2 35 Sandy Clay on Caliche Sand Streaks Gravel, Loose Firm Drilling 141 144 Yellow Sandy Clay, Soft 35 50 Cemented Sand, Small Gravel, Very Tight, Hard Drilling 144 153 Coarse Sand, Small to Medium Gravel, Loose 50 62 Green Sandy Clay, Very Hard, Some Caliche 153 161 Fine to Medium Sand, Firm Drilling 62 78 Fine to Medium Sand, Firm But Not Tight 161 168 Yellow Clay 78 85 Sandstone Hard 168 180 Blue Shale 85 98 Cemented Sandy Clay on Caliche Streaks 98 124 Sandy Yellow Clay, Some Fine Sand Streaks, Soft									
7 CONTRACTOR'S OR LANDOWNER'S CERTIFICATION: This water well was (1) constructed (2) reconstructed, or (3) plugged under my jurisdiction and was completed on (mo/day/year) 5-15-91 and this record is true to the best of my knowledge and belief. Kansas Water Well Contractor's License No. 514 This Water Well Record was completed on (mo/day/yr) 6-4-91 under the business name of Miller Gearhead & Pump, Inc. by (signature) <i>Ernest Miller</i>									