


1 LOCATION OF WATER WELL: Fraction SE 1/4 SW 1/4 NE 1/4 Section Number 20 Township Number T 18 S Range Number R 40 EW

Distance and direction from nearest town or city street address of well if located within city?
400 W. Lawrence

2 WATER WELL OWNER: USD #200
RR#, St. Address, Box #: 400 W. Lawrence Board of Agriculture, Division of Water Resources
City, State, ZIP Code: Tribune, Kansas 67879 Application Number:

3 LOCATE WELL'S LOCATION WITH AN "X" IN SECTION BOX:

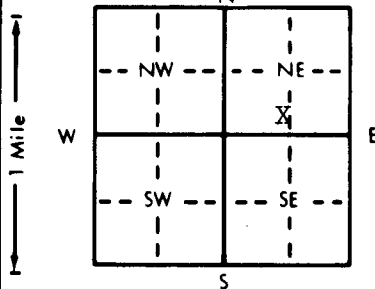

4 DEPTH OF COMPLETED WELL: 113 ft. ELEVATION:

Depth(s) Groundwater Encountered 1. 101 ft. 2. ft. 3. ft.
WELL'S STATIC WATER LEVEL 98.71 ft. below land surface measured on mo/day/yr 4/12/93
Pump test data: Well water was ft. after hours pumping gpm
Est. Yield gpm: Well water was ft. after hours pumping gpm
Bore Hole Diameter 6.25 in. to 113 ft., and in. to ft.
WELL WATER TO BE USED AS: 5 Public water supply 8 Air conditioning 11 Injection well
1 Domestic 3 Feedlot 6 Oil field water supply 9 Dewatering 12 Other (Specify below)
2 Irrigation 4 Industrial 7 Lawn and garden only 10 Monitoring well MW-4
Was a chemical/bacteriological sample submitted to Department? Yes No X; If yes, mo/day/yr sample was submitted Water Well Disinfected? Yes No X

5 TYPE OF BLANK CASING USED: 1 Steel 3 RMP (SR) 5 Wrought iron 8 Concrete tile CASING JOINTS: Glued Clamped
2 PVC 4 ABS 6 Asbestos-Cement 9 Other (specify below) Welded
7 Fiberglass Threaded X
Blank casing diameter 2 in. to 113 ft. Dia. in. to ft. Dia. in. to ft.
Casing height above land surface 0.0 in., weight lbs./ft. Wall thickness or gauge No. Schd. 40

TYPE OF SCREEN OR PERFORATION MATERIAL: 1 Steel 3 Stainless steel 5 Fiberglass 7 PVC 10 Asbestos-cement
2 Brass 4 Galvanized steel 6 Concrete tile 8 RMP (SR) 11 Other (specify)
12 None used (open hole)

SCREEN OR PERFORATION OPENINGS ARE: 1 Continuous slot 3 Mill slot 5 Gauzed wrapped 8 Saw cut 11 None (open hole)
2 Louvered shutter 4 Key punched 6 Wire wrapped 9 Drilled holes
7 Torch cut 10 Other (specify)

SCREEN-PERFORATED INTERVALS: From 113 ft. to 93 ft. From ft. to ft.
GRAVEL PACK INTERVALS: From 113 ft. to 90 ft. From ft. to ft.

6 GROUT MATERIAL: 1 Neat cement 2 Cement grout 3 Bentonite 4 Other
Grout intervals: From 90 ft. to 93 ft. From 93 ft. to 0.0 ft. From ft. to ft.

What is the nearest source of possible contamination:
1 Septic tank 4 Lateral lines 7 Pit privy 10 Livestock pens 14 Abandoned water well
2 Sewer lines 5 Cess pool 8 Sewage lagoon 11 Fuel storage 15 Oil well/Gas well
3 Watertight sewer lines 6 Seepage pit 9 Feedyard 12 Fertilizer storage 16 Other (specify below)
13 Insecticide storage
How many feet?

FROM	TO	LITHOLOGIC LOG	FROM	TO	PLUGGING INTERVALS
0	5	Silty Clay, Loam, Tan, Dry	105	113	Clay, Yellow, Fat
5	15	Silty Clay, Med Brn., Lean			
15	20	Silty Clay, Med. Brn., -Yellow, Lean			
20	25	Clay, Yellow, Lean. Sand, Rust, Fn-Med Gr.			Caliche
25	30	Sand, Rust, Med-Lg Gr. Gravel, Sm, Caliche			
30	35	Caliche, Buff, Sand, Rust, Fn-Med Gr.			
35	45	Sand, Rust, Med-Lg Gr. Caliche			
45	50	Sand, Gray, Fn-Med Gr. Caliche			
50	60	Sand, Rust, Fn-Med Gr. Caliche			
60	65	Sand, Gray-Buff, Fn. Gr. Some Caliche			
65	75	Sand, Tan-Buff, Med-Lg Gr. Gravel Sm-Lg.			
75	80	Sand, Buff, Fn-Lg Gr. Gravel, Med-Lg, Caliche			
80	90	Sand, Buff, Fn-Med Gr. Some Caliche			
90	100	Sand, Buff, Fn. Gr. Gravel, Sm-Med, Caliche			
100	105	Sand, Tan, Med-Lg. Clay, Yellow, Fat			

7 CONTRACTOR'S OR LANDOWNER'S CERTIFICATION: This water well was (1) constructed (2) reconstructed, or (3) plugged under my jurisdiction and was completed on (mo/day/year) 11/10/92 and this record is true to the best of my knowledge and belief. Kansas Water Well Contractor's License No. 540 This Water Well Record was completed on (mo/day/yr) 4/12/93 under the business name of Prairie Land Environmental Remediation, Inc. (signature)

INSTRUCTIONS: Use typewriter or ball point pen. PLEASE PRESS FIRMLY and PRINT clearly. Please fill in blanks, underline or circle the correct answers. Send top three copies to Kansas Department of Health and Environment, Bureau of Water, Topeka, Kansas 66620-0001. Telephone: 913-296-5545. Send one to WATER WELL OWNER and retain one for your records.