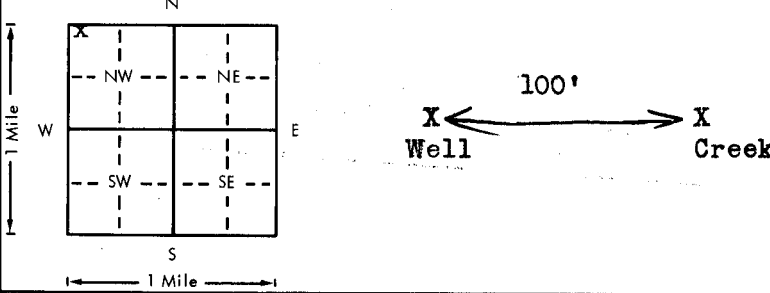


USE TYPEWRITER OR BALL
POINT PEN-PRESS FIRMLY,
PRINT CLEARLY.

WATER WELL RECORD
KSA 82a-1201-1215

Kansas Department of Health and
Environment-Division of Environment
(Water well Contractors)
Topeka, Kansas 66620

1. Location of well:		County Greeley	Fraction NW 1/4 NW 1/4 NW 1/4	Section number 26	Township number T 18 S	Range number R 40 W
2. Distance and direction from nearest town or city: 2 Miles East of Tribune, Kansas Street address of well location if in city:			3. Owner of well: Hoffman Farms R.R. or street: Tribune, Kansas 67879 City, state, Zip code:			
4. Locate with "X" in section below:		Sketch map:		6. Bore hole dia. 9 in. Completion date 6/12/79 Well depth 70 ft.		
				7. Cable tool <input checked="" type="checkbox"/> Rotary <input checked="" type="checkbox"/> Driven <input type="checkbox"/> Dug Hollow rod <input type="checkbox"/> Jetted <input type="checkbox"/> Bored <input type="checkbox"/> Reverse rotary		
5. Type and color of material		From	To	8. Use: <input checked="" type="checkbox"/> Domestic <input type="checkbox"/> Public supply <input type="checkbox"/> Industry <input type="checkbox"/> Irrigation <input type="checkbox"/> Air conditioning <input type="checkbox"/> Stock <input type="checkbox"/> Lawn <input type="checkbox"/> Oil field water <input type="checkbox"/> Other		
Clay		0	19	9. Casing: Material Plastic Weight: Above or below Threaded <input type="checkbox"/> Welded <input checked="" type="checkbox"/> Surface 12 in. RMP <input checked="" type="checkbox"/> PVC <input type="checkbox"/> Weight 1.8 lbs./ft. Dia. 0 in. to 60 ft. depth Wall Thickness: inches or Dia. <input type="checkbox"/> in. to <input type="checkbox"/> ft. depth gage No. 250		
Sand		19	31	10. Screen: Manufacturer's name Jess & Lowell Type RMP Dia. 5" Slot/gauze 1/16" Length 10' Set between 60 ft. and 70 ft. ft. and <input type="checkbox"/> ft. Gravel pack? yes Size range of material 1/4 x 1/8		
Sand Rock		31	47	11. Static water level: <input type="checkbox"/> mo./day/yr. 60 ft. below land surface Date 6/12/79		
Fine sand		47	58	12. Pumping level below land surfaces: NA <input type="checkbox"/> ft. after <input type="checkbox"/> hrs. pumping <input type="checkbox"/> g.p.m. <input type="checkbox"/> ft. after <input type="checkbox"/> hrs. pumping <input type="checkbox"/> g.p.m. Estimated maximum yield <input type="checkbox"/> g.p.m.		
Sand cemented streaks		58	63	13. Water sample submitted: <input type="checkbox"/> mo./day/yr. <input type="checkbox"/> Yes <input checked="" type="checkbox"/> No Date <input type="checkbox"/>		
Clay yellow		63	70	14. Well head completion: <input type="checkbox"/> Pitless adapter 12 inches above grade		
Shale		70		15. Well grouted? yes With: <input checked="" type="checkbox"/> Neat cement <input type="checkbox"/> Bentonite <input type="checkbox"/> Concrete Depth: From 0 ft. to 15 ft.		
				16. Nearest source of possible contamination: ft. 100 Direction East Type Creek Well disinfected upon completion? <input checked="" type="checkbox"/> Yes <input type="checkbox"/> No		
				17. Pump: <input checked="" type="checkbox"/> Not installed Manufacturer's name <input type="checkbox"/> Model number <input type="checkbox"/> HP <input type="checkbox"/> Volts <input type="checkbox"/> Length of drop pipe <input type="checkbox"/> ft. capacity <input type="checkbox"/> g.p.m. Type: <input type="checkbox"/> Submersible <input type="checkbox"/> Turbine <input type="checkbox"/> Jet <input type="checkbox"/> Reciprocating <input type="checkbox"/> Centrifugal <input type="checkbox"/> Other		
				20. Water well contractor's certification: This well was drilled under my jurisdiction and this report is true to the best of my knowledge and belief. Weishaar Drilling & Sup 232 Business name License No. Address South City, Kansas 67871 Signed [Signature] Date 6/12/79 Authorized representative		
18. Elevation:		19. Remarks: TOPO 3545				
Topography: <input type="checkbox"/> Hill <input checked="" type="checkbox"/> Slope <input type="checkbox"/> Upland <input type="checkbox"/> Valley						