


USE TYPEWRITER OR BALL POINT PEN-PRESS FIRMLY, PRINT CLEARLY.

WATER WELL RECORD
KSA 82a-1201-1215

Kansas Department of Health and Environment-Division of Environment (Water well Contractors) Topeka, Kansas 66620

1. Location of well: County Greeley Fraction SW 1/4 SW 1/4 NE 1/4 Section number 2 30 Township number T 18 S R 40 E

2. Distance and direction from nearest town or city: 2W, 1/2S, 1/2E of 3. Owner of well: Dennis Schneider
Street address of well location if in city: Tribune, Kansas R.R. or street:
City, state, zip code: Tribune, KS 67879

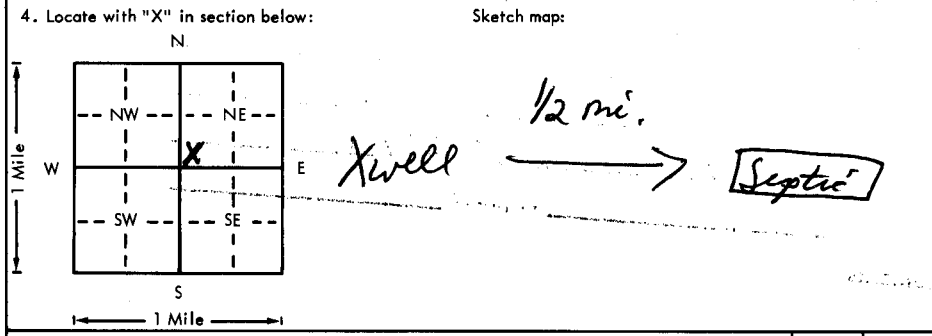

6. Bore hole dia. 9 in. Completion date 1-12-77
Well depth 125 ft.
7. Cable tool Rotary Driven Dug
 Hollow rod Jetted Bored Reverse rotary
8. Use: Domestic Public supply Industry
 Irrigation Air conditioning Stock
 Lawn Oil field water Other
9. Casing: Material Plas. Height: Above or below
Threaded Welded Glue Surface 12 in.
RMP PVC Weight 1.8 lbs./ft.
Dia. 5 in. to 105 ft. depth Wall Thickness: inches or
Dia. in. to ft. depth gage No. 250

5. Type and color of material	From	To
Clay	0	35
Fine sd clay	35	58
Gyp H	58	63
Fine sd clay	63	68
Sd coarse	68	78
Fine sd clay	78	87
Sd rock	87	90
Sdy clay	90	97
Sd coarse	97	105
Fine sd clay	105	115
Sd coarse	115	123
Yellow	123	125
(Use a second sheet if needed)		

10. Screen: Manufacturer's name Jess & Lowell
Type RMP Dia. 5 in.
 gauze 1/16 Length 20 ft.
Set between 105 ft. and 125 ft.
 ft. and ft.
Gravel pack? Yes Size range of material 1/4-1/8
11. Static water level: 108 ft. below land surface Date 1-12-77
12. Pumping level below land surfaces: NA
 ft. after hrs. pumping g.p.m.
 ft. after hrs. pumping g.p.m.
Estimated maximum yield g.p.m.
13. Water sample submitted: mo./day/yr.
 Yes No Date
14. Well head completion: NA
 Pitless adapter 12 Inches above grade
15. Well grouted? Yes
With: Neat cement Bentonite Concrete
Depth: From 0 ft. to 15 ft.
16. Nearest source of possible contamination: 2640 ft. Direction East Type Septic
Well disinfected upon completion? Yes No
17. Pump: Not installed
Manufacturer's name
Model number HP Volts
Length of drop pipe ft. capacity g.p.m.
Type:
 Submersible Turbine
 Jet Reciprocating
 Centrifugal Other

18. Elevation: Topography: Hill Slope Upland Valley
19. Remarks: Well not finished by us, so don't know well head completion or pumping level.

20. Water well contractor's certification: This well was drilled under my jurisdiction and this report is true to the best of my knowledge and belief.
Weishaar Drilling 232
Business name License No.
Address 3007 City, KS 67871
Signed [Signature] Date 2-3-77
Authorized representative

T 18
R 40
E
S
30
SW
1/4
1/4
1/4