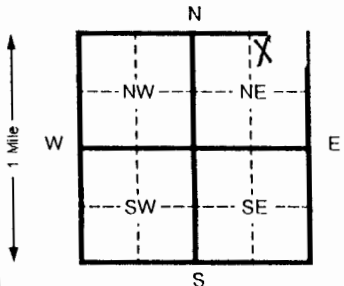


1 LOCATION OF WATER WELL: Fraction ^{NW}/_{NE} ^{NE}/_{NE} ^{NE}/_{NE} Section Number 29 Township Number T 18 S Range Number R 40 E ^N

County: Greeley Distance and direction from nearest town or city street address of well if located within city? Ks Hwy 96 & 27, Tribune, Kansas

2 WATER WELL OWNER: United Plains Ag RR#, St. Address, Box #: PO Box 20 Board of Agriculture, Division of Water Resources City, State, ZIP Code: Sharon Springs, Ks 67758 Application Number:

3 LOCATE WELL'S LOCATION WITH AN "X" IN SECTION BOX:  4 DEPTH OF COMPLETED WELL 107 ~~105~~ ft. ELEVATION: Depth(s) Groundwater Encountered 1 ft. 2 ft. 3 ft. WELL'S STATIC WATER LEVEL 99.34 ft. below land surface measured on mo/day/yr Pump test data: Well water was ft. after hours pumping gpm Est. Yield gpm: Well water was ft. after hours pumping gpm Bore Hole Diameter 8 in. to 115 ft. and in. to ft. WELL WATER TO BE USED AS: 5 Public water supply 8 Air conditioning 11 Injection well 1 Domestic 3 Feed lot 6 Oil field water supply 9 Dewatering 12 Other (Specify below) 2 Irrigation 4 Industrial 7 Lawn and garden (domestic) 10 Monitoring well Was a chemical/bacteriological sample submitted to Department? Yes No If yes, mo/day/yr sample was submitted Water Well Disinfected? Yes No

5 TYPE OF BLANK CASING USED: 1 Steel 3 RMP (SR) 5 Wrought Iron 8 Concrete tile CASING JOINTS: Glued Clamped 2 PVC 4 ABS 6 Asbestos-Cement 9 Other (specify below) Welded 7 Fiberglass Threaded Blank casing diameter 4 in. to 82 ~~80~~ ft. Dia in. to ft. Dia in. to ft. Casing height above land surface 0 in. weight 2.071 lbs./ft. Wall thickness or gauge No. .237 TYPE OF SCREEN OR PERFORATION MATERIAL: 1 Steel 3 Stainless steel 5 Fiberglass 8 RMP (SR) 10 Asbestos-cement 2 Brass 4 Galvanized steel 6 Concrete tile 9 ABS 11 Other (specify) 12 None used (open hole) SCREEN OR PERFORATION OPENINGS ARE: 1 Continuous slot 3 Mill slot 5 Gauzed wrapped 8 Saw cut 11 None (open hole) 2 Louvered shutter 4 Key punched 6 Wire wrapped 9 Drilled holes 10 Other (specify) 7 Torch cut SCREEN-PERFORATED INTERVALS: From 82 ~~80~~ ft. to 107 ~~105~~ ft. From ft. to ft. GRAVEL PACK INTERVALS: From 78 ft. to 107 ~~105~~ ft. From ft. to ft.

6 GROUT MATERIAL: 1 Neat cement 2 Cement grout 3 Bentonite 4 Other Grout Intervals From 1 ft. to 76 ~~78~~ ft. From ft. to ft. From ft. to ft. What is the nearest source of possible contamination: 1 Septic tank 4 Lateral lines 7 Pit privy 10 Livestock pens 14 Abandoned water well 2 Sewer lines 5 Cess pool 8 Sewage lagoon 11 Fuel storage 15 Oil well/ Gas well 3 Watertight sewer lines 6 Seepage pit 9 Feedyard 12 Fertilizer storage 16 Other (specify below) contaminated site Direction from well? How many feet?

FROM	TO	CODE	LITHOLOGIC LOG	FROM	TO	PLUGGING INTERVALS
0	2		Surface			
2	15		Silt			
15	34		Caliche w/clay lenses & traces Of sand			
34	43		Fine & med sand w/caliche strk & traces of clay			
43	57		Faine & med sand & gravel w/ Caliche lenses			
57	64		Fine & med sand w/caliche lens			
64	86		Fine to some med sand w/ Caliche strks			
86	94		Fine & med sand w/caliche lens			
94	115		Fine & med sand w/clay strks			

7 CONTRACTOR'S OR LANDOWNER'S CERTIFICATION: This water well was (1) constructed, (2) reconstructed, or (3) plugged under my jurisdiction and was completed on (mo/day/yr) 9/30/08 and this record is true to the best of my knowledge and belief. Kansas Water Well Contractor's License No. 783 This Water Well Record was completed on (mo/day/yr) 10/07/08 under the business name of Woofter Pump & Well Inc. by (signature)

INSTRUCTIONS: Please fill in blanks and circle the correct answers. Send three copies to Kansas Department of Health and Environment, Bureau of Water, 1000 S W Jackson St., Ste. 420, Topeka, Kansas 66612-1367. Telephone: 913-296-5545. Send one to WATER WELL OWNER and retain one for your records.

OFFICE USE ONLY

RECEIVED
NOV 17 2008
BUREAU OF WATER