KOLAR Document ID: 1470474

SV-4

WATER WELL PLUGGING RECORD Form WWC-5P KSA 82a-1212 ID NO.

1 LOCATION OF WATER WELL: County: Greeley | Fraction: SE ¼ NE ¼ NE ¼ NE ¼ | Section Number: 29 | Township Number: 18 T S | Range Number: 40 ☐ E ☐ W

Street/Rural Address of Well Location; if unknown, distance & direction from nearest town or intersection: If at owner's address, check here ☐ Junction of KS Hwy 96 & 27
Tribune, KS 67879

Global Positioning Systems (GPS) information:
Latitude: 38.464517 (in decimal degrees)
Longitude: 101.753103 (in decimal degrees)
Elevation: 3607
Datum: ☑ WGS84, ☐ NAD83, ☐ NAD27
Collection Method:
☑ GPS unit (Make/Model: Where Am I? app
☐ Digital Map/Photo, ☐ Topographic Map, ☐ Land Survey
Est. Accuracy: ☑ < 3 m, ☐ 3-5 m, ☐ 5-15 m, ☐ > 15 m

2 WATER WELL OWNER: United Plains Ag
RR#, St. Address, Box #: P.O. Box 280
City, State ZIP Code: Sharon Springs KS 67758

3 MARK WELL'S LOCATION WITH AN "X" IN SECTION BOX:

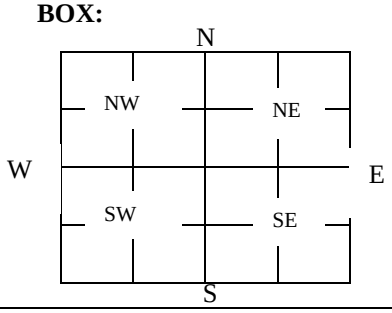

4 DEPTH OF WELL 29 **ft.**

WELL'S STATIC WATER LEVEL 0 ft

WELL WAS USED AS:

☐ Domestic	☐ Public Water Supply	☐ Dewatering	
☐ Irrigation	☐ Oil Field Water Supply	☐ Monitoring	
☐ Feedlot	☐ Domestic (Lawn & Garden)	☐ Injection Well	
☐ Industrial	☐ Air Conditioning	☑ Other SVE	

Was a chemical/bacteriological sample submitted to Department? Yes ☐ No ☑

5 TYPE OF BLANK CASING USED:

☐ Steel	☐ RMP (SR)	☐ Wrought	☐ Fiberglass	☐ Other (Specify below)
☑ PVC	☐ ABS	☐ Asbestos-Cement	☐ Concrete Tile	

Blank casing diameter 4 in. Was casing pulled? Yes ☐ No ☑ If yes, how much _____
Casing height above or below land surface 0 in.

6 GROUT PLUG MATERIAL: ☐ Neat cement ☐ Cement grout ☑ Bentonite ☐ Other _____

Grout Plug Intervals: From 0.5 ft. to 29 ft., From _____ ft. to _____ft., From _____ ft. to _____ ft.

What is the nearest source of possible contamination:

☐ Septic tank	☐ Seepage pit	☑ Fuel storage	☐ Other (specify below)
☐ Sewer lines	☐ Pit privy	☐ Fertilizer storage	
☐ Watertight sewer lines	☐ Sewage lagoon	☐ Insecticide storage	
☐ Lateral lines	☐ Feedyard	☐ Abandoned water well	Direction from well? North
☐ Cess pool	☐ Livestock pens	☐ Oil well/Gas well	How many feet? 150

FROM	TO	PLUGGING MATERIALS	FROM	TO	PLUGGING MATERIALS
0.5	29	Bentonite			

7 CONTRACTOR'S OR LANDOWNER'S CERTIFICATION: This water well was plugged under my jurisdiction and was completed on (mo/day/year) 8/14/2019 and this record is true to the best of my knowledge and belief. Kansas Water Well Contractor's License No. 708. This Water Well Record was completed on (mo/day/year) 8/29/2019 under the business name of Leah A. Meyer by (signature) _____

Send one white copy to Kansas Department of Health & Environment, Geology Section, 1000 SW Jackson Street, Ste. 420, Topeka, KS 66612-1367. Send one copy to WATER WELL OWNER and retain one for your records.
Visit us at http://www.kdheks.gov/waterwell/index.html Telephone 785-296-5524.

KSA82a-1212 **Revised 1/29/2014**