


MW-2

1 LOCATION OF WATER WELL: County: Greeley Fraction: NE 1/4 NE 1/4 NE 1/4 Section Number: 25 Township Number: T 18 S Range Number: R 41 EW

Distance and direction from nearest town or city street address of well if located within city?
1.5 miles West of Tribune on Highway 96

2 WATER WELL OWNER: Ron's Oil Company, Inc
 RR#, St. Address, Box #: RR #1 Box 145
 City, State, ZIP Code: Tribune, KS
 Board of Agriculture, Division of Water Resources
 Application Number: _____

3 LOCATE WELL'S LOCATION WITH AN "X" IN SECTION BOX:

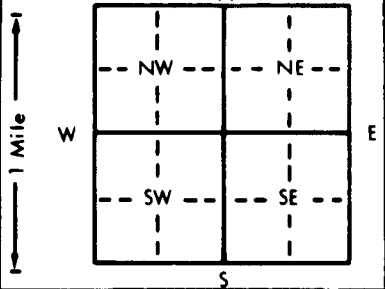

4 DEPTH OF COMPLETED WELL: 119.50 ft. ELEVATION: 3644.19

Depth(s) Groundwater Encountered: 1. 105 ft. 2. _____ ft. 3. _____ ft.
 WELL'S STATIC WATER LEVEL: 104.68 ft. below land surface measured on mo/day/yr: 8/28/95
 Pump test data: Well water was _____ ft. after _____ hours pumping _____ gpm
 Est. Yield _____ gpm: Well water was _____ ft. after _____ hours pumping _____ gpm
 Bore Hole Diameter: 12.0 in. to 12.5 in. and _____ in. to _____ in.
 WELL WATER TO BE USED AS:
 5 Public water supply 8 Air conditioning 11 Injection well
 1 Domestic 3 Feedlot 6 Oil field water supply 9 Dewatering 12 Other (Specify below)
 2 Irrigation 4 Industrial 7 Lawn and garden only Monitoring well MW-2
 Was a chemical/bacteriological sample submitted to Department? Yes _____ No ; If yes, mo/day/yr sample was submitted _____
 Water Well Disinfected? Yes _____ No

5 TYPE OF BLANK CASING USED:
 1 Steel 3 RMP (SR) 5 Wrought iron 8 Concrete tile CASING JOINTS: Glued _____ Clamped _____
 PVC 4 ABS 6 Asbestos-Cement 9 Other (specify below) Welded _____
 7 Fiberglass Threaded

Blank casing diameter: 0 in. to 99.5 ft., Dia 4 in. to _____ ft., Dia _____ in. to _____ ft.
 Casing height above land surface: 0.0 in., weight _____ lbs./ft. Wall thickness or gauge No. Sch 40

TYPE OF SCREEN OR PERFORATION MATERIAL:
 1 Steel 3 Stainless steel 5 Fiberglass 8 RMP (SR) 10 Asbestos-cement
 2 Brass 4 Galvanized steel 6 Concrete tile 9 ABS 11 Other (specify) _____
 12 None used (open hole)

SCREEN OR PERFORATION OPENINGS ARE:
 1 Continuous slot Mill slot 5 Gauzed wrapped 8 Saw cut 11 None (open hole)
 2 Louvered shutter 4 Key punched 99.5 6 Wire wrapped 9 Drilled holes
 7 Torch cut 119.50 10 Other (specify) _____

SCREEN-PERFORATED INTERVALS: From 99.5 ft. to 119.50 ft., From _____ ft. to _____ ft.
 From _____ ft. to _____ ft., From _____ ft. to _____ ft.
 GRAVEL PACK INTERVALS: From 95 ft. to 125 ft., From _____ ft. to _____ ft.
 From _____ ft. to _____ ft., From _____ ft. to _____ ft.

6 GROUT MATERIAL: 1 Neat cement 2 Cement grout 90 Bentonite 95 4 Other _____
 Grout Intervals: From 0 ft. to 90 ft., From 90 ft. to 95 ft., From _____ ft. to _____ ft.

What is the nearest source of possible contamination:
 1 Septic tank 4 Lateral lines 7 Pit privy 10 Livestock pens 14 Abandoned water well
 2 Sewer lines 5 Cess pool 8 Sewage lagoon Fuel storage 15 Oil well/Gas well
 3 Watertight sewer lines 6 Seepage pit 9 Feedyard 12 Fertilizer storage 16 Other (specify below)
 13 Insecticide storage
 Direction from well? North How many feet? 100ft

FROM	TO	LITHOLOGIC LOG	FROM	TO	PLUGGING INTERVALS
0	14.9	silty Sand			
14.9	19.5	fine to medium Sand			
19.5	30.0	silty Sand			
30	40.0	clayey silty Sand			
40	45	fine to coarse Sand			
45	64	fine to coarse sand with gravel			
64	80	Sand and gravel cemented with calcium carbonate			
80	101	clayey silty Sand with gravel			
101	125	sandy gravel			

7 CONTRACTOR'S OR LANDOWNER'S CERTIFICATION: This water well was (1) constructed, (2) reconstructed, or (3) plugged under my jurisdiction and was completed on (mo/day/year) 8/25 8/31/95 and this record is true to the best of my knowledge and belief. Kansas Water Well Contractor's License No. 540 This Water Well Record was completed on (mo/day/yr) 8/15/95 under the business name of Prairie Land Environmental Remediation Inc by (signature)