


1	LOCATION OF WATER WELL:	Fraction	Section Number	Township Number	Range Number
County: Greeley		NE <sub>4</sub> NE <sub>4</sub> NE <sub>4</sub>	25	18 S	41 <b>EW</b>

Distance and direction from nearest town or city street address of well if located within city?  
 1.5 miles west of Tribune on Highway 96

2 WATER WELL OWNER: Ron's Oil Company, Inc  
 RR #1 Box 145  
 RR #, St. Address, Box #: Tribune, KS 67879 MW-1 Board of Agriculture, Division of Water Resources  
 City, State, ZIP Code : Application Number:

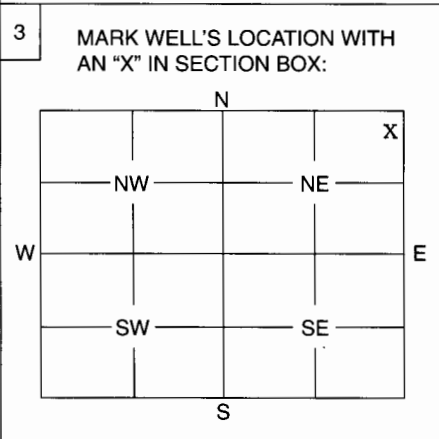

4 DEPTH OF WELL 119.91 ft.  
 WELL'S STATIC WATER LEVEL 104.51 ft.  
 WELL WAS USED AS:  
 1 Domestic 5 Public Water Supply 9 Dewatering  
 2 Irrigation 6 Oil Field Water Supply 10 Monitoring Well MW-1  
 3 Feedlot 7 Domestic (Lawn & Garden) 11 Injection Well  
 4 Industrial 8 Air Conditioning 12 Other .....

Was a chemical / bacteriological sample submitted to Department? Yes ..... No ..X.....  
 If yes, mo/day/yr sample was submitted .....

Water Well Disinfected: Yes ..... No ..X.....

5 TYPE OF BLANK CASING USED:  
 1 Steel 3 RMP (SR) 5 Wrought 7 Fiberglass 9 Other (Specify below)  
 2 PVC 4 ABS 6 Asbestos-Cement 8 Concrete Tile .....

Blank casing diameter 2 in. Was casing pulled? Yes ..X No ..... If yes, how much 4.5'  
 Casing height above or below land surface 53 in.

6 GROUT PLUG MATERIAL: 1 Neat cement  2 Cement grout  3 Bentonite 4 Other .....

GROUT PLUG INTERVALS: From 0 ft. to 3 ft., From 3 ft. to 119.91 ft., From ..... to ..... ft.

What is the nearest source of possible contamination:  
 1 Septic tank 6 Seepage pit  11 Fuel storage 16 Other (specify below)  
 2 Sewer lines 7 Pit privy 12 Fertilizer storage .....

3 Watertight sewer lines 8 Sewage lagoon 13 Insecticide storage  
 4 Lateral lines 9 Feedyard 14 Abandoned water well  
 5 Cess pool 10 Livestock pens 15 Oil well/Gas well

Direction from well? ..NW..... How many feet? .....80'.....

FROM	TO	PLUGGING MATERIALS
0	3	Native soil
3	119.91	Volclay 20-30% solids Bentonite Grout

7 CONTRACTOR'S OF LANDOWNER'S CERTIFICATION: This water well was plugged under my jurisdiction and was completed on (mo/day/year) 09-20-05 and this record is true to the best of my knowledge and belief. Kansas Water Well Contractor's License No. 735 This Water Well Record was completed on (mo/day/year) ..... under the business name of MILCO Environmental Services, Inc. by (signature) *D. A. T. J.*

INSTRUCTIONS: Use typewriter or ball point pen. Please press firmly and print clearly. Please fill in blanks, underline or circle the correct answers. Send top three copies to Kansas Department of Health and Environment, Bureau of Water, Geology Section, 1000 SW Jackson St., Ste. 420, Topeka, Kansas 66612-1367. Telephone: 785/296-5522. Send one to Water Well Owner and retain one for your records.