


1 LOCATION OF WATER WELL: Fraction Section Number Township Number Range Number
 County: Greeley NE 1/4 NE 1/4 NE 1/4 25 18S 41 E/W

Distance and direction from nearest town or city street address of well if located within city?
1.5 miles west of Tribune on Highway 96

2 WATER WELL OWNER: Ron's Oil Company, Inc
RR #1 Box 145
 RR #, St. Address, Box #: Tribune, KS 67879 MW2
 City, State, ZIP Code : Board of Agriculture, Division of Water Resources
Application Number:

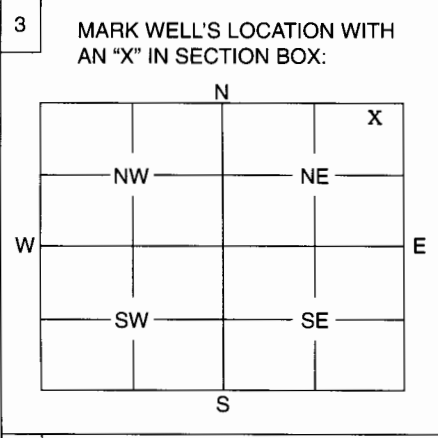

4 DEPTH OF WELL 109.30 ft.
 WELL'S STATIC WATER LEVEL 103.45 ft.
 WELL WAS USED AS:
 1 Domestic 2 Irrigation 3 Feedlot 4 Industrial 5 Public Water Supply 6 Oil Field Water Supply 7 Domestic (Lawn & Garden) 8 Air Conditioning 9 Dewatering 10 Monitoring Well 11 Injection Well 12 Other
MW-2
 Was a chemical / bacteriological sample submitted to Department? Yes No X.....
 If yes, mo/day/yr sample was submitted
 Water Well Disinfected: Yes No X.....

5 TYPE OF BLANK CASING USED:
 1 Steel 2 PVC 3 RMP (SR) 4 ABS 5 Wrought 6 Asbestos-Cement 7 Fiberglass 8 Concrete Tile 9 Other (Specify below)
 Blank casing diameter 2 in. Was casing pulled? Yes X No If yes, how much 4.5'
 Casing height above or below land surface 53' in.

6 GROUT PLUG MATERIAL: 1 Neat cement 2 Cement grout 3 Bentonite 4 Other
 Grout Plug Intervals: From 0 ft. to 3 ft., From 3 ft. to 109.30 ft., From to ft.
 What is the nearest source of possible contamination:
 1 Septic tank 2 Sewer lines 3 Watertight sewer lines 4 Lateral lines 5 Cess pool 6 Seepage pit 7 Pit privy 8 Sewage lagoon 9 Feedyard 10 Livestock pens 11 Fuel storage 12 Fertilizer storage 13 Insecticide storage 14 Abandoned water well 15 Oil well/Gas well 16 Other (specify below)
 Direction from well? NE How many feet? 85'

FROM	TO	PLUGGING MATERIALS
0	3	Native soil
3	109	Volclay 20-30% solids Bentonite Grout

7 CONTRACTOR'S OF LANDOWNER'S CERTIFICATION: This water well was plugged under my jurisdiction and was completed on (mo/day/year) 09-20-05 and this record is true to the best of my knowledge and belief. Kansas Water Well Contractor's License No. 735 This Water Well Record was completed on (mo/day/year)
 by (signature) [Signature] under the business name of MILCO Environmental Services, Inc.

INSTRUCTIONS: Use typewriter or ball point pen. Please press firmly and print clearly. Please fill in blanks, underline or circle the correct answers. Send top three copies to Kansas Department of Health and Environment, Bureau of Water, Geology Section, 1000 SW Jackson St., Ste. 420, Topeka, Kansas 66612-1367. Telephone: 785/296-5522. Send one to Water Well Owner and retain one for your records.