


1 LOCATION OF WATER WELL: Fraction NE 1/4 NW 1/4 SW 1/4 Section Number 9 Township Number T 18 S Range Number R 5

Distance and direction from nearest town or city street address of well if located within city?  
 4 miles South & 3 miles West of Marquette, KS

2 WATER WELL OWNER: ~~Morrison Enterprises~~ *Summit Producers Company*  
 RR#, St. Address, Box #: 1700 E. Iron Board of Agriculture, Division of Water Resources  
 City, State, ZIP Code: Salina, KS 67401 Application Number:

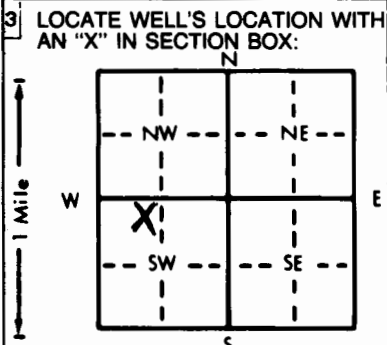

4 DEPTH OF COMPLETED WELL: 54 ft. ELEVATION: ... ft.  
 Depth(s) Groundwater Encountered 1. 21'6" ft. 2. ... ft. 3. ... ft.  
 WELL'S STATIC WATER LEVEL 21'6" ft. below ~~land surface~~ *Top of casing* measured on mo/day/yr 1-16-89  
 Pump test data: Well water was ... ft. after ... hours pumping ... gpm  
 Est. Yield ~~80~~ gpm: Well water was ... ft. after ... hours pumping ... gpm  
 Bore Hole Diameter 8 in. to 56 ft., and ... in. to ... ft.  
 WELL WATER TO BE USED AS: 5 Public water supply 8 Air conditioning 11 Injection well  
 1 Domestic 3 Feedlot 6 Oil field water supply 9 Dewatering 12 Other (Specify below)  
 2 Irrigation 4 Industrial 7 Lawn and garden only 10 Observation well  
 Was a chemical/bacteriological sample submitted to Department? Yes ... No X ...; if yes, mo/day/yr sample was submitted  
 Water Well Disinfected? Yes X No

5 TYPE OF BLANK CASING USED:  
 1 Steel 3 RMP (SR) 5 Wrought iron 8 Concrete tile CASING JOINTS: Glued ... Clamped  
 2 PVC 4 ABS 6 Asbestos-Cement 9 Other (specify below) Welded ...  
 7 Fiberglass ... Threaded ...  
 Blank casing diameter 5 in. to 34 ft., Dia ... in. to ... ft., Dia ... in. to ... ft.  
 Casing height above land surface 17 in., weight 2.91 lbs./ft. Wall thickness or gauge No. 265.  
 TYPE OF SCREEN OR PERFORATION MATERIAL:  
 1 Steel 3 Stainless steel 5 Fiberglass 7 PVC 10 Asbestos-cement  
 2 Brass 4 Galvanized steel 6 Concrete tile 8 RMP (SR) 11 Other (specify) ...  
 9 ABS 12 None used (open hole)  
 SCREEN OR PERFORATION OPENINGS ARE:  
 1 Continuous slot 3 Mill slot 5 Gauzed wrapped 8 Saw cut 11 None (open hole)  
 2 Louvered shutter 4 Key punched 6 Wire wrapped 9 Drilled holes  
 7 Torch cut 10 Other (specify) ...  
 SCREEN-PERFORATED INTERVALS: From 34 ft. to 54 ft., From ... ft. to ... ft.  
 GRAVEL PACK INTERVALS: From 20 ft. to 54 ft., From ... ft. to ... ft.

6 GROUT MATERIAL: 1 Neat cement 2 Cement grout 3 Bentonite 4 Other ...  
 Grout Intervals: From 0 ft. to 20 ft., From ... ft. to ... ft., From ... ft. to ... ft.  
 What is the nearest source of possible contamination:  
 1 Septic tank 4 Lateral lines 7 Pit privy 10 Livestock pens 14 Abandoned water well  
 2 Sewer lines 5 Cess pool 8 Sewage lagoon 11 Fuel storage 15 Oil well/Gas well  
 3 Watertight sewer lines 6 Seepage pit 9 Feedyard - Proposed 12 Fertilizer storage 16 Other (specify below)  
 13 Insecticide storage  
 Direction from well? Southeast How many feet? 5000

FROM	TO	LITHOLOGIC LOG	FROM	TO	LITHOLOGIC LOG
0	3	Top Soil			
3	8	Brown Clay			
8	54	Sandstone			
54	56	Shale			

7 CONTRACTOR'S OR LANDOWNER'S CERTIFICATION: This water well was (1) constructed, (2) reconstructed, or (3) plugged under my jurisdiction and was completed on (mo/day/year) 1-16-89 and this record is true to the best of my knowledge and belief. Kansas  
 Water Well Contractor's License No. 138 This Water Well Record was completed on (mo/day/yr) 1-24-89  
 under the business name of Peterson Irrigation, Inc. by (signature) *Mike Peterson*

INSTRUCTIONS: Use typewriter or ball point pen. PLEASE PRESS FIRMLY and PRINT clearly. Please fill in blanks, underline or circle the correct answers. Send top three copies to Kansas Department of Health and Environment, Bureau of Water Protection, Topeka, Kansas 66620-7320, Telephone: 913-862-9360. Send one to WATER WELL OWNER and retain one for your records.