


1. WELL: *McPherson* SECTION: *SE 1/4 SE 1/4* TWP: *23* R: *5* EW: *18*

2. WATER WELL OWNER: *Eldon M. DeWitt*
 Board of Agriculture, Division of Water Resources
 Application Number: *1-12-89*
 Address: *5 3/4 S of Marquette Mo., Marquette Kansas 67464*

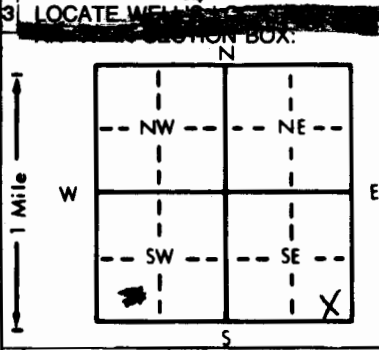

4. DEPTH(S) GROUNDWATER ENCOUNTERED: *103* ft. ELEVATION: *30'* ft. below land surface
 Pump test data: Well water was _____ ft. after _____ hours pumping _____ gpm
 Est. Yield _____ gpm: Well water was _____ ft. after _____ hours pumping _____ gpm
 Bore Hole Diameter _____ in. to _____ ft., and _____ in. to _____ ft.
 1 Domestic *✓* 3 Feedlot 5 Public water supply 8 Air conditioning 11 Injection well
 2 Irrigation 4 Industrial 6 Oil field water supply 9 Dewatering 12 Other (Specify below)
 7 Lawn and garden only 10 Monitoring well
 Was a chemical/bacteriological sample submitted to Department? Yes _____ No _____; If yes, mo/day/yr sample was submitted _____

5. CASING MATERIAL: *NONE*
 1 Steel 3 RMP (SR) 5 Wrought iron 8 Concrete tile CASING JOINTS: Glued _____ Clamped _____
 2 PVC 4 ABS 6 Asbestos-Cement 9 Other (specify below) Welded _____
 7 Fiberglass Threaded _____
 Dia _____ in. to _____ ft., Dia _____ in. to _____ ft.
 weight _____ lbs./ft. Wall thickness or gauge No. _____

6. TYPE OF SCREEN OR PERFORATION MATERIAL:
 1 Steel 3 Stainless steel 5 Fiberglass 7 PVC 10 Asbestos-cement
 2 Brass 4 Galvanized steel 6 Concrete tile 8 RMP (SR) 11 Other (specify) _____
 12 None used (open hole)

7. SCREEN OR PERFORATION OPENINGS ARE:
 1 Continuous slot 3 Mill slot 5 Gauzed wrapped 8 Saw cut 11 None (open hole)
 2 Louvered shutter 4 Key punched 6 Wire wrapped 9 Drilled holes
 7 Torch cut 10 Other (specify) _____

8. SCREEN-PERFORATED INTERVALS: From _____ ft. to _____ ft., From _____ ft. to _____ ft.
 GRAVEL PACK INTERVALS: From _____ ft. to _____ ft., From _____ ft. to _____ ft.

9. GROUT MATERIALS:
 1 Neat cement 2 Cement grout 3 Bentonite 4 Other _____
 From _____ ft. to _____ ft., From _____ ft. to _____ ft.
 What is the nearest source of possible contamination:
 1 Septic tank 4 Lateral lines 7 Pit privy 10 Livestock pens 14 Abandoned water well
 2 Sewer lines 5 Cess pool 8 Sewage lagoon 11 Fuel storage 15 Oil well/Gas well
 3 Watertight sewer lines 6 Seepage pit 9 Feedyard 12 Fertilizer storage 16 Other (specify below)
 13 Insecticide storage

			FROM	TO	PLUGGING INTERVALS
<i>103</i>	<i>30</i>	<i>Sand & Gravel</i>			
<i>30</i>	<i>6</i>	<i>Cement Grout</i>			
		<i>6' to top of pit Top soil</i>			

7. CONTRACTOR'S OR OWNER'S CERTIFICATION: This water well was (1) constructed, (2) reconstructed, or (3) plugged under my jurisdiction and was completed on *1-18-89* and this record is true to the best of my knowledge and belief. Kansas Water Well Contractor's License No. _____ This Water Well _____ under the business name of _____