


1	LOCATION OF WATER WELL:	Fraction	Section	Number	Township	Number	Range	Number
	County: <u>Rice</u>	<u>SW</u> $\frac{1}{4}$ $\frac{1}{4}$	<u>28</u>		<u>18</u>		<u>7</u>	E/W

Distance and direction from nearest town or city street address of well if located within city?

2 WATER WELL OWNER: Edward R + Beth Case
 RR #, St. Address, Box #: 2735 Ave. H Board of Agriculture, Division of Water Resources
 City, State, ZIP Code: Little River, KS 67457 Application Number:

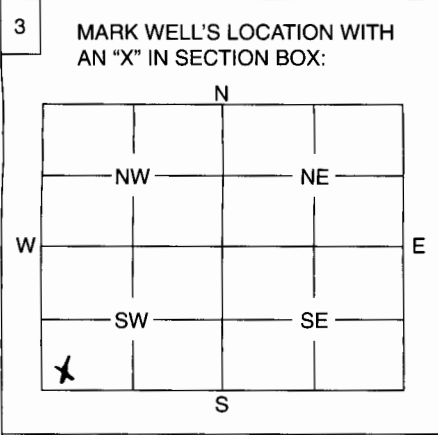

4 DEPTH OF WELL 60 ft.
 WELL'S STATIC WATER LEVEL 40.0 ft.
 WELL WAS USED AS:
 Domestic 5 Public Water Supply 9 Dewatering
 Irrigation 6 Oil Field Water Supply 10 Monitoring Well
 Feedlot 7 Domestic (Lawn & Garden) 11 Injection Well
 Industrial 8 Air Conditioning 12 Other

Was a chemical / bacteriological sample submitted to Department? Yes No
 If yes, mo/day/yr sample was submitted

Water Well Disinfected: Yes No

5 TYPE OF BLANK CASING USED:
 Steel 3 RMP (SR) 5 Wrought 7 Fiberglass 9 Other (Specify below)
 PVC 4 ABS 6 Asbestos-Cement 8 Concrete Tile

Blank casing diameter 6 in. Was casing pulled? Yes No If yes, how much

Casing height above or below land surface 2.4 in. in.

6 GROUT PLUG MATERIAL: 1 Neat cement 2 Cement grout 3 Bentonite 4 Other

Grout Plug Intervals: From ft. to ft., From ft. to ft., From to ft.

What is the nearest source of possible contamination:

1 Septic tank	6 Seepage pit	11 Fuel storage	16 Other (specify below)
2 Sewer lines	7 Pit privy	12 Fertilizer storage	<u>Lagoon</u>
3 Watertight sewer lines	8 Sewage lagoon	13 Insecticide storage	<u>200ft South</u>
4 Lateral lines	9 Feedyard	14 Abandoned water well	
5 Cess pool	<input checked="" type="radio"/> Livestock pens	15 Oil well/Gas well	

Direction from well? 152 East How many feet?

FROM	TO	PLUGGING MATERIALS
		3gal. Chlorox in bottom
60'	25'	Sand
25'	25'	Topsoil
25'	21'	Bentonite
up to top		Topsoil

7 CONTRACTOR'S OF LANDOWNER'S CERTIFICATION: This water well was plugged under my jurisdiction and was completed on (mo/day/year) and this record is true to the best of my knowledge and belief. Kansas Water Well Contractor's License No. This Water Well Record was completed on (mo/day/year) under the business name of by (signature) Edward R Case

INSTRUCTIONS: Use typewriter or ball point pen. Please press firmly and print clearly. Please fill in blanks, underline or circle the correct answers. Send top three copies to Kansas Department of Health and Environment, Bureau of Water, Geology Section, 1000 SW Jackson St., Ste. 420, Topeka, Kansas 66612-1367. Telephone: 785/296-5522. Send one to Water Well Owner and retain one for your records.