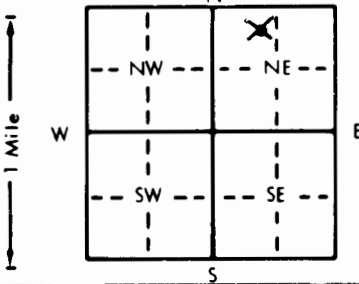


1 LOCATION OF WATER WELL: County: RICE		Fraction NE 1/4 NW 1/4 NE 1/4	Section Number 8	Township Number T 18 S	Range Number R 7 NW
Distance and direction from nearest town or city street address of well if located within city? 1 mile South & 2 3/4 Miles East of Geneseo, KS					
2 WATER WELL OWNER: Zephyr Project RR#, St. Address, Box #: c/o Lisa Tokach, 320NE 14th St. City, State, ZIP Code: Abilene, KS 67410			Board of Agriculture, Division of Water Resources Application Number: 43,164		
3 LOCATE WELL'S LOCATION WITH AN "X" IN SECTION BOX: <div style="text-align: center;"></div>		4 DEPTH OF COMPLETED WELL: 76 ft. ELEVATION: Depth(s) Groundwater Encountered 1. ft. 2. ft. 3. ft. WELL'S STATIC WATER LEVEL: 30 ft. below land surface measured on mo/day/yr 5/1/98 Pump test data: Well water was ft. after hours pumping gpm Est. Yield 10-15 gpm: Well water was ft. after hours pumping gpm Bore Hole Diameter: 9 in. to 76 ft. and in. to ft. WELL WATER TO BE USED AS: 5 Public water supply 8 Air conditioning 11 Injection well 1 Domestic <input checked="" type="checkbox"/> Feedlot 6 Oil field water supply 9 Dewatering 12 Other (Specify below) 2 Irrigation 4 Industrial 7 Lawn and garden only 10 Monitoring well Was a chemical/bacteriological sample submitted to Department? Yes No <input checked="" type="checkbox"/> If yes, mo/day/yr sample was submitted Water Well Disinfected? Yes <input checked="" type="checkbox"/> No			
5 TYPE OF BLANK CASING USED: 1 Steel 3 RMP (SR) <input checked="" type="checkbox"/> PVC 4 ABS		5 Wrought iron 8 Concrete tile CASING JOINTS: Glued <input checked="" type="checkbox"/> Clamped 6 Asbestos-Cement 9 Other (specify below) Welded 7 Fiberglass Threaded			
Blank casing diameter 5 in. to 56 ft. Dia. in. to ft. Dia. in. to ft. Casing height above land surface: 12 in. weight 2.37 lbs./ft. Wall thickness or gauge No. .214					
TYPE OF SCREEN OR PERFORATION MATERIAL: 1 Steel 3 Stainless steel 5 Fiberglass 8 RMP (SR) 2 Brass 4 Galvanized steel 6 Concrete tile 9 ABS		10 Asbestos-cement 11 Other (specify) 12 None used (open hole)			
SCREEN OR PERFORATION OPENINGS ARE: 1 Continuous slot <input checked="" type="checkbox"/> Mill slot 2 Louvered shutter 4 Key punched		5 Gauzed wrapped 8 Saw cut 11 None (open hole) 6 Wire wrapped 9 Drilled holes 7 Torch cut 10 Other (specify)			
SCREEN-PERFORATED INTERVALS: From 56 ft. to 76 ft. From ft. to ft. From ft. to ft. From ft. to ft.					
GRAVEL PACK INTERVALS: From 20 ft. to 76 ft. From ft. to ft. From ft. to ft. From ft. to ft.					
6 GROUT MATERIAL: 1 Neat cement 2 Cement grout <input checked="" type="checkbox"/> Bentonite 4 Other		Grout Intervals: From 0 ft. to 20 ft. From ft. to ft. From ft. to ft.			
What is the nearest source of possible contamination: 1 Septic tank 4 Lateral lines 7 Pit privy 10 Livestock pens 14 Abandoned water well 2 Sewer lines 5 Cess pool <input checked="" type="checkbox"/> Sewage lagoon 11 Fuel storage 15 Oil well/Gas well 3 Watertight sewer lines 6 Seepage pit 9 Feedyard 12 Fertilizer storage 16 Other (specify below) 13 Insecticide storage					
Direction from well? East		How many feet? 400			
FROM TO LITHOLOGIC LOG		FROM TO PLUGGING INTERVALS			
0	3	Top Soil			
3	15	Tan Clay			
15	30	Gray Shale			
30	33	Brown Sandstone			
33	42	Red Shale			
42	60	Tan Sandstone			
60	64	Gray Shale			
64	74	Gray Sandstone			
74	76	Gray Shale			
7 CONTRACTOR'S OR LANDOWNER'S CERTIFICATION: This water well was (<input checked="" type="checkbox"/> constructed, (2) reconstructed, or (3) plugged under my jurisdiction and was completed on (mo/day/year) 5/1/98 and this record is true to the best of my knowledge and belief. Kansas Water Well Contractor's License No. 138 This Water Well Record was completed on (mo/day/yr) 5/8/98 under the business name of Peterson Irrigation, Inc. by (signature) <i>Mike Petersen</i>					
INSTRUCTIONS: Use typewriter or ball point pen. PLEASE PRESS FIRMLY and PRINT clearly. Please fill in blanks, underline or circle the correct answers. Send top three copies to Kansas Department of Health and Environment, Bureau of Water, Topeka, Kansas 66620-0001. Telephone: 913-296-5545. Send one to WATER WELL OWNER and retain one for your records.					

OFFICE USE ONLY

T

R

EW

SEC.

1/4

1/4

1/4