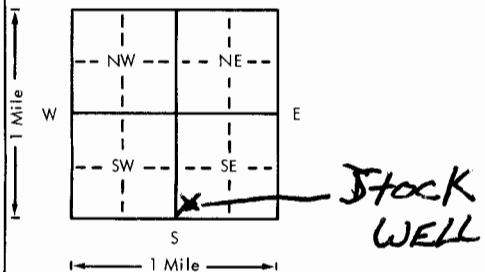


USE TYPEWRITER OR BALL POINT PEN-PRESS FIRMLY, PRINT CLEARLY.

WATER WELL RECORD  
KSA 82a-1201-1215

Kansas Department of Health and Environment-Division of Environment  
(Water well Contractors)  
Topeka, Kansas 66620

|   |                       |  |   |   |  |
|---|-----------------------|--|---|---|--|
| 1. Location of well:  | County<br><b>RICE</b> | Fraction<br><b>SW 1/4 SW 1/4 SE 1/4</b>            | Section number<br><b>26</b>   | Township number<br><b>T 18 S R 7</b>                | Range number<br><b>7</b>   |
| 2. Distance and direction from nearest town or city:<br><b>4 mi NORTH AND 3 mi WEST OF LITTLE RIVER, KSO</b>  |                       | 3. Owner of well:<br><b>Wayne Phillips R.R. #1</b> |   | City, state, zip code:<br><b>Geneseo, Ks. 67444</b> |  |
| 4. Locate with "X" in section below:<br>N<br>W<br>E<br>S<br>1 Mile  |                       |  | Sketch map:<br>   |   |  |
| 5. Type and color of material   |                       |  | From  | To  | 6. Bore hole dia. <b>8 1/2</b> in. Completion date <b>10-18-78</b><br>Well depth <b>66</b> ft.   |
| <b>Top soil</b>   |                       |  | <b>0</b>  | <b>3</b>  | 7. <input type="checkbox"/> Cable tool <input checked="" type="checkbox"/> Rotary <input type="checkbox"/> Driven <input type="checkbox"/> Dug<br><input type="checkbox"/> Hollow rod <input type="checkbox"/> Jetted <input type="checkbox"/> Bored <input type="checkbox"/> Reverse rotary   |
| <b>Brown clay</b>   |                       |  | <b>3</b>  | <b>32</b>   | 8. Use: <input checked="" type="checkbox"/> Domestic <input type="checkbox"/> Public supply <input type="checkbox"/> Industry<br><input type="checkbox"/> Irrigation <input type="checkbox"/> Air conditioning <input checked="" type="checkbox"/> Stock<br><input type="checkbox"/> Lawn <input type="checkbox"/> Oil field water <input type="checkbox"/> Other  |
| <b>Brown sandy clay</b>   |                       |  | <b>32</b>   | <b>50</b>   | 9. Casing: Material _____ Height: <b>0</b> above or below<br>Threaded _____ Welded _____ Surface <b>12</b> in.<br>RMP _____ PVC <input checked="" type="checkbox"/> Weight <b>2</b> lbs./ft.<br>Dia. <b>4</b> in. to <b>56</b> ft. depth Wall Thickness: inches or<br>Dia. _____ in. to _____ ft. depth gage No. <b>.25</b>  |
| <b>Sandstone layers mixed with white sandy clay</b>   |                       |  | <b>50</b>   | <b>65</b>   | 10. Screen: Manufacturer's name <b>Peerless Plastics</b><br>Type <b>PVC</b> Dia. <b>4"</b><br>Slot/gauze <b>1/16</b> Length <b>10'</b><br>Set between <b>56</b> ft. and <b>66</b> ft.<br>_____ ft. and _____ ft.<br>Gravel pack? <input checked="" type="checkbox"/> Size range of material <b>4/4</b>   |
| <b>Blue shale</b>   |                       |  | <b>65</b>   | <b>66</b>   | 11. Static water level: _____ mo./day/yr.<br><b>34</b> ft. below land surface Date <b>10/18/78</b>   |
|   |                       |  |   |   | 12. Pumping level below land surfaces:<br>_____ ft. after <b>1 1/2</b> hrs. pumping <b>10</b> g.p.m.<br>_____ ft. after _____ hrs. pumping _____ g.p.m.<br>Estimated maximum yield <b>12</b> g.p.m.  |
|   |                       |  |   |   | 13. Water sample submitted: _____ mo./day/yr.<br><input type="checkbox"/> Yes <input checked="" type="checkbox"/> No Date _____  |
|   |                       |  |   |   | 14. Well head completion:<br><input type="checkbox"/> Pitless adapter <b>12</b> Inches above grade   |
|   |                       |  |   |   | 15. Well grouted? <b>Yes</b><br>With: <input checked="" type="checkbox"/> Neat cement <input type="checkbox"/> Bentonite <input type="checkbox"/> Concrete<br>Depth: From <b>0</b> ft. to <b>10</b> ft.  |
|   |                       |  |   |   | 16. Nearest source of possible contamination:<br>ft. <b>75</b> Direction <b>South</b> Type <b>cattle</b><br>Well disinfected upon completion? <input checked="" type="checkbox"/> Yes <input type="checkbox"/> No  |
|   |                       |  |   |   | 17. Pump: <input checked="" type="checkbox"/> Not installed<br>Manufacturer's name _____<br>Model number _____ HP _____ Volts _____<br>Length of drop pipe _____ ft. capacity _____ g.p.m.<br>Type:<br><input type="checkbox"/> Submersible <input type="checkbox"/> Turbine<br><input type="checkbox"/> Jet <input type="checkbox"/> Reciprocating<br><input type="checkbox"/> Centrifugal <input type="checkbox"/> Other |
|   |                       |  | (Use a second sheet if needed)  |   |  |
| 18. Elevation:  | 19. Remarks:          |  | 20. Water well contractor's certification:<br>This well was drilled under my jurisdiction and this report is true to the best of my knowledge and belief.<br><b>PETERSON IRRIGATION 138</b><br>Business name _____ License No. _____<br>Address <b>Box 150 Lindsay, Ks</b><br>Signed <b>Mike Peterson</b> Date <b>11-15-78</b><br>Authorized representative |   |  |
| Topography:<br><input checked="" type="checkbox"/> Hill<br><input type="checkbox"/> Slope<br><input type="checkbox"/> Upland<br><input type="checkbox"/> Valley |                       |  |   |   |  |

T  
R  
18 - 70  
26  
SW SW SE  
1/4 1/4 1/4