


USE TYPEWRITER OR BALL POINT PEN-PRESS FIRMLY, PRINT CLEARLY.

WATER WELL RECORD  
KSA 82a-1201-1215

Kansas Department of Health and Environment  
Division of Environment  
(Water well Contractors)  
Topeka, Kansas 66620

1. Location of well: County Rice Fraction 1/4 1/4 1/4 Section number 17 Township number T 18 S R 8 N1 E/W Range number

2. Distance and direction from nearest town or city: 1/2 IN 1/2 N STERLING 3. Owner of well: Charles Carder  
Street address of well location if in city: RED R.R. or street: RED  
City, state, zip code: Sterling, Kan. 67579

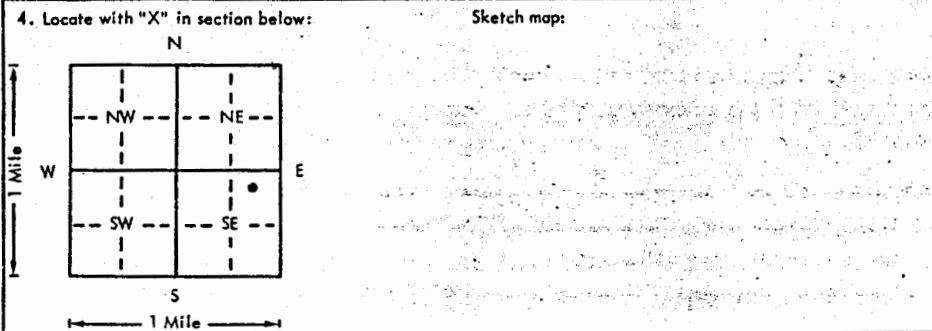

6. Bore hole dia. 32 in. Completion date \_\_\_\_\_  
Well depth 80 ft.  
7.  Cable tool  Rotary  Driven  Dug  
 Hollow rod  Jetted  Bored  Reverse rotary  
8. Use:  Domestic  Public supply  Industry  
 Irrigation  Air conditioning  Stock  
 Lawn  Oil field water  Other  
9. Casing: Material galvanized Height: Above or below  
Threaded  Welded  Surface \_\_\_\_\_ in.  
RMP \_\_\_\_\_ PVC \_\_\_\_\_ Weight \_\_\_\_\_ lbs./ft.  
Dia. 1 1/2 in. to \_\_\_\_\_ ft. depth | Wall Thickness: inches or  
Dia. \_\_\_\_\_ in. to \_\_\_\_\_ ft. depth | gage No. 1/16

5. Type and color of material	From	To
Soil to med. sand	0	5
Med. sand	5	10
Med. to coarse gravel	10	15
Med. to fine sand	15	20
Med. sand	20	30
Med. to coarse sand	30	55
Med. to fine sand	55	80
Fine sand to shale	80	85
(Use a second sheet if needed)		

10. Screen: Manufacturer's name Johnson  
Type casual Dia. 1 1/2  
Slot/gauze 1/16 Length \_\_\_\_\_  
Set between \_\_\_\_\_ ft. and \_\_\_\_\_ ft.  
\_\_\_\_\_ ft. and \_\_\_\_\_ ft.  
Gravel pack? yes Size range of material 1/8-1/4  
11. Static water level: \_\_\_\_\_ mo./day/yr.  
67.5 ft. below land surface Date \_\_\_\_\_  
12. Pumping level below land surfaces:  
12 ft. after \_\_\_\_\_ hrs. pumping 1110 g.p.m.  
7 ft. after \_\_\_\_\_ hrs. pumping 550 g.p.m.  
Estimated maximum yield \_\_\_\_\_ g.p.m.  
13. Water sample submitted: \_\_\_\_\_ mo./day/yr.  
 Yes  No Date \_\_\_\_\_  
14. Well head completion: \_\_\_\_\_ Pitless adapter \_\_\_\_\_ Inches above grade  
15. Well grouted? yes  
With:  Neat cement  Bentonite  Concrete  
Depth: From \_\_\_\_\_ ft. to \_\_\_\_\_ ft.  
16. Nearest source of possible contamination:  
ft. \_\_\_\_\_ Direction \_\_\_\_\_ Type \_\_\_\_\_  
Well disinfected upon completion?  Yes  No  
17. Pump:  Not installed  
Manufacturer's name \_\_\_\_\_  
Model number \_\_\_\_\_ HP \_\_\_\_\_ Volts \_\_\_\_\_  
Length of drop pipe \_\_\_\_\_ ft. capacity \_\_\_\_\_ g.p.m.  
Type:  
 Submersible  Turbine  
 Jet  Reciprocating  
 Centrifugal  Other

18. Elevation: \_\_\_\_\_  
19. Remarks: \_\_\_\_\_  
Topography:  
 Hill  
 Slope  
 Upland  
 Valley

20. Water well contractor's certification:  
This well was drilled under my jurisdiction and this report is true to the best of my knowledge and belief.  
Darling Drilling Co. 129  
Business name \_\_\_\_\_ License No. \_\_\_\_\_  
Address 111 W. 4th, Hutchinson, Ks.  
Signed \_\_\_\_\_ Date \_\_\_\_\_  
Authorized representative