


1 LOCATION OF WATER WELL: County: <u>Rice</u>	Fraction <u>NN 1/4 SW 1/4 NW 1/4</u>	Section Number <u>5</u>	Township Number <u>18 S</u>	Range Number <u>9 W</u>
--	---	----------------------------	--------------------------------	----------------------------

Distance and direction from nearest town or city street address of well if located within city?  
K-4 and Eighth Road

2 WATER WELL OWNER: Kansas Gas Service  
 RR#, St. Address, Box #: 200 SW 6th, PO Box 7538 Board of Agriculture, Division of Water Resources  
 City, State, ZIP Code: Topeka, KS 66603 Application Number:

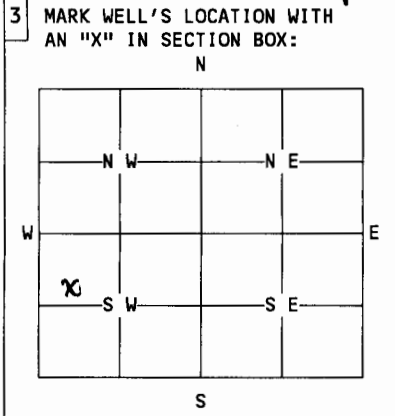

4 DEPTH OF WELL... 180.4 .....ft.  
 WELL'S STATIC WATER LEVEL... 06.88 .....ft.  
 WELL WAS USED AS:  
 1 Domestic      5 Public Water Supply      9 Dewatering  
 2 Irrigation    6 Oil Field Water Supply    10 Monitoring Well  
 ③ Feedlot       7 Lawn and Garden Only    11 Injection Well  
 4 Industrial    8 Air Conditioning        12 Other.....  
 Was a chemical/bacteriological sample submitted to Department? Yes....No. X  
 If yes, mo/day/yr sample was submitted.....  
 Water Well Disinfected: Yes..... No. X

5 TYPE OF BLANK CASING USED:  
 ① Steel    3 RMP (SR)    5 Wrought    7 Fiberglass    9 Other (specify below)  
 ② PVC    4 ABS        6 Asbestos-Cement    8 Concrete Tile  
 Blank casing diameter... 5 .....in.    Was casing pulled? Yes..... No..... X Attempted  
 Casing height above or below land surface... 0 .....in.

6 GROUT PLUG MATERIAL: 1 Neat cement    2 Cement grout    ③ Bentonite    4 Other.....  
 Grout Plug Intervals: From 0 .....ft. to 180.4 .....ft., From.....ft. to .....ft., From..... to .....ft.  
 What is the nearest source of possible contamination:  
 1 Septic tank                      6 Seepage pit                      11 Fuel storage                      16 Other (specify below)  
 2 Sewer lines                      7 Pit privy                          12 Fertilizer storage  
 3 Watertight sewer lines        8 Sewage lagoon                    13 Insecticide storage  
 4 Lateral lines                      9 Feedyard                          14 Abandoned water well  
 5 Cess Pool                          ⑩ Livestock pens                    15 Oil well/Gas well  
 Direction from well? East .....                      How many feet? 10 .....

FROM	TO	PLUGGING MATERIALS
<u>180.4</u>	<u>0</u>	<u>Hydrated Bentonite</u>

7 CONTRACTOR'S OR LANDOWNER'S CERTIFICATION: This water well was plugged under my jurisdiction and was completed on (mo/day/year) 8/24/98 ..... and this record is true to the best of my knowledge and belief. Kansas Water Well Contractor's License No. 527 ..... This Water Well Record was completed on (mo/day/year) 8/27/98 ..... under the business name of Geocore Services, Inc. by (signature) Dob. R.H.

INSTRUCTIONS: Use typewriter or ball point pen. Please press firmly and print clearly. Please fill in blanks, underline or circle the correct answers. Send top three copies to Kansas Department of Health and Environment, Bureau of Water, Topeka, Kansas 66620-0001. Telephone: 913/296-3565. Send one to Water Well Owner and retain one for your records.