


03-1913D

WATER WELL PLUGGING RECORD Form WWC-5P KSA 82a-1212 ID NO.

1 LOCATION OF WATER WELL: County: Rice Fraction 1/4 1/4 NW 1/4 NE 1/4 Section Number 6 Township Number T 18 S Range Number 9

Street/Rural Address of Well Location; if unknown, distance & direction from nearest town or intersection: If at owner's address, check here OneOK Facility (Kinder Morgan) 777 Y Avenue Bushton KS 67427 Global Positioning Systems (GPS) information: Latitude: 38.521673 Longitude: -98.359983

2 WATER WELL OWNER: KMI RR#, St. Address, Box #: 1001 Louisiana Street City, State ZIP Code: Houston TX 77002 Est. Accuracy: 3-5 m

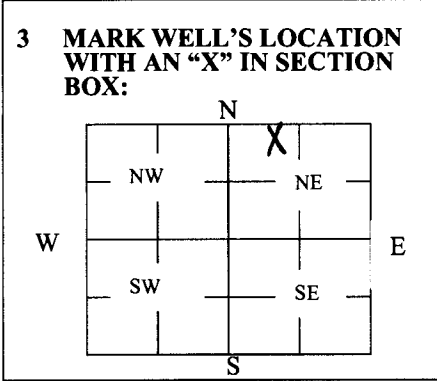

4 DEPTH OF WELL 82 ft. WELL'S STATIC WATER LEVEL _____ ft. WELL WAS USED AS: Dewatering Monitoring

5 TYPE OF BLANK CASING USED: Steel PVC, RMP (SR) ABS, Wrought Asbestos-Cement, Fiberglass Concrete Tile, Other (Specify below)

6 GROUT PLUG MATERIAL: Neat cement, Cement grout, Bentonite, Other Top Soil. Grout Plug Intervals: From 0 ft. to 3 ft., From 3 ft. to 82 ft.

What is the nearest source of possible contamination: Fuel storage, Fertilizer storage, Insecticide storage, Abandoned water well, Oil well/Gas well

Table with columns: FROM, TO, PLUGGING MATERIALS. Row 1: 0 to 3, Top Soil. Row 2: 3 to 82, Bentonite.

7 CONTRACTOR'S OR LANDOWNER'S CERTIFICATION: This water well was plugged under my jurisdiction and was completed on (mo/day/year) 09/29/2016 and this record is true to the best of my knowledge and belief.

Send one white copy to Kansas Department of Health & Environment, Geology Section, 1000 SW Jackson Street, Ste. 420, Topeka, KS 66612-1367. Visit us at http://www.kdheks.gov/waterwell/index.html Telephone 785-296-5524.