

WATER WELL PLUGGING RECORD Form WWC-5P
KSA 82a-1212
ID NO.
MW-2

1 LOCATION OF WATER WELL: County: <u>Rice</u>	Fraction <u>NE 1/4 SW 1/4 NE 1/4</u>	Section Number <u>6</u>	Township Number <u>T 18 S</u>	Range Number <u>9</u> <input type="checkbox"/> E <input checked="" type="checkbox"/> W
---	---	----------------------------	----------------------------------	---

Street/Rural Address of Well Location; if unknown, distance & direction from nearest town or intersection: If at owner's address, check here ☐ Northern Natural Gas Bushton Compressor Station

Global Positioning Systems (GPS) information:

Latitude: 38.519586 (in decimal degrees)

Longitude: 98.352403 (in decimal degrees)

Elevation: NA

Horizontal Datum: ☒ WGS84, ☐ NAD83, ☐ NAD27

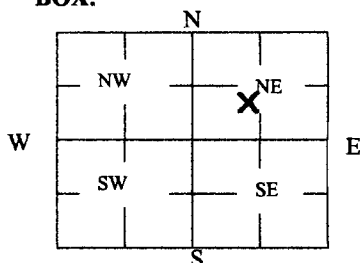
Collection Method:

☐ GPS unit (Make/Model: _____)

☒ Digital Map/Photo, ☐ Topographic Map, ☐ Land Survey

Est. Accuracy: ☐ < 3 m, ☐ 3-5 m, ☐ 5-15 m, ☐ > 15 m

2 WATER WELL OWNER: Northern Natural Gas
RR#, St. Address, Box #: 1111 S. 103rd Street
City, State ZIP Code: Omaha, NE 68121

3 MARK WELL'S LOCATION WITH AN "X" IN SECTION BOX:

4 DEPTH OF WELL 44.40 ft.

WELL'S STATIC WATER LEVEL 21.52 ft

WELL WAS USED AS:

- ☐ Domestic
☐ Irrigation
☐ Feedlot
☐ Industrial

- ☐ Public Water Supply
☐ Oil Field Water Supply
☐ Domestic (Lawn & Garden)
☐ Air Conditioning

- ☐ Dewatering
☒ Monitoring
☐ Injection Well
☐ Other _____

Was a chemical/bacteriological sample submitted to Department? Yes ☐ No ☒

5 TYPE OF BLANK CASING USED:

- ☐ Steel ☐ RMP (SR) ☐ Wrought ☐ Fiberglass ☐ Other (Specify below) _____
☒ PVC ☐ ABS ☐ Asbestos-Cement ☐ Concrete Tile

Blank casing diameter _____ in. Was casing pulled? Yes ☒ No ☐ If yes, how much 5 ft.

Casing height above or below land surface 0 in.

6 GROUT PLUG MATERIAL: ☐ Neat cement ☐ Cement grout ☒ Bentonite ☐ Other _____

Grout Plug Intervals: From 0 ft. to 44.40 ft., From _____ ft. to _____ ft., From _____ ft. to _____ ft.

What is the nearest source of possible contamination:

- ☐ Septic tank ☐ Seepage pit ☐ Fuel storage ☒ Other (specify below) _____
☐ Sewer lines ☐ Pit privy ☐ Fertilizer storage Compressor Station
☐ Watertight sewer lines ☐ Sewage lagoon ☐ Insecticide storage
☐ Lateral lines ☐ Feedyard ☐ Abandoned water well Direction from well? _____
☐ Cess pool ☐ Livestock pens ☐ Oil well/Gas well How many feet? _____

FROM	TO	PLUGGING MATERIALS	FROM	TO	PLUGGING MATERIALS
0	44.40	Bentonite			

7 CONTRACTOR'S OR LANDOWNER'S CERTIFICATION: This water well was plugged under my jurisdiction and was completed on (mo/day/year) 7/15/2020 and this record is true to the best of my knowledge and belief. Kansas Water Well Contractor's License No. 604. This Water Well Record was completed on (mo/day/year) 8/6/2020 under the business name of Environmental Priority Service, Inc. by (signature) [Signature]

Send one white copy to Kansas Department of Health & Environment, Geology Section, 1000 SW Jackson Street, Ste. 420, Topeka, KS 66612-1367. Send one copy to WATER WELL OWNER and retain one for your records.
Visit us at <http://www.kdheks.gov/waterwell/index.html> Telephone 785-296-5524.

KSA82a-1212
Revised 1/20/2015