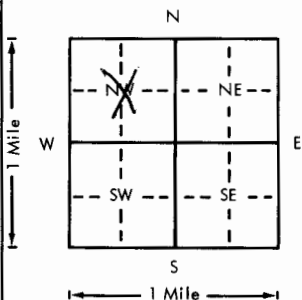


USE TYPEWRITER OR BALL
POINT PEN-PRESS FIRMLY,
PRINT CLEARLY.

WATER WELL RECORD
KSA 82a-1201-1215

Kansas Department of Health and
Environment-Division of Environment
(Water well Contractors)
Topeka, Kansas 66620

1. Location of well:		County <u>Pice</u>	Fraction <u>C/NW</u> 1/4 1/4 1/4	Section number <u>8</u>	Township number <u>T 18 S</u>	Range number <u>R 9 W E 1</u>
2. Distance and direction from nearest town or city: <u>2 E 1/4 S Bashton</u> Street address of well location if in city:				3. Owner of well: <u>Bill Mollhagen</u> R.R. or street: City, state, zip code: <u>Lorraine Ks.</u>		
4. Locate with "X" in section below:		Sketch map:		6. Bore hole dia. <u>24</u> in. Completion date <u>7-11-75</u> Well depth <u>230</u> ft.		
				7. Cable tool <input checked="" type="checkbox"/> Rotary <input type="checkbox"/> Driven <input type="checkbox"/> Dug <input type="checkbox"/> Hollow rod <input type="checkbox"/> Jetted <input type="checkbox"/> Bored <input type="checkbox"/> Reverse rotary		
5. Type and color of material				From	To	8. Use: <input type="checkbox"/> Domestic <input type="checkbox"/> Public supply <input type="checkbox"/> Industry <input type="checkbox"/> Irrigation <input type="checkbox"/> Air conditioning <input type="checkbox"/> Stock <input type="checkbox"/> Lawn <input type="checkbox"/> Oil field water <input type="checkbox"/> Other
Top Soil				0	3	9. Casing: Material <u>Steel</u> Height: <u>Above</u> or below Threaded <input type="checkbox"/> Welded <input checked="" type="checkbox"/> Surface <u>18</u> in. RMP <input type="checkbox"/> PVC <input type="checkbox"/> Weight <input type="checkbox"/> lbs./ft. Dia. <u>16</u> in. to <u>230</u> ft. depth Wall Thickness: inches or Dia. <input type="checkbox"/> in. to <input type="checkbox"/> ft. depth Gauge No. <u>7</u>
Brown Clay				3	11	10. Screen: Manufacturer's name <u>Duerst</u> Type <u>Steel</u> Dia. <u>16</u> Slot/gauge <u>3/16</u> Length <u>60</u> Set between <u>170</u> ft. and <u>230</u> ft. <input type="checkbox"/> ft. and <input type="checkbox"/> ft. Gravel pack? <input type="checkbox"/> Size range of material <u>1/2 3/4 3/8</u>
Yellow & Brown Clay				11	74	11. Static water level: <u>55</u> ft. below land surface Date <u>2-8-75</u> mo./day/yr.
Sand Rock				74	80	12. Pumping level below land surfaces: <u>44</u> ft. after <u>1/2</u> hrs. pumping <u>1000</u> g.p.m. <input type="checkbox"/> ft. after <input type="checkbox"/> hrs. pumping <input type="checkbox"/> g.p.m. Estimated maximum yield <u>1100</u> g.p.m.
Shale				80	90	13. Water sample submitted: <input checked="" type="checkbox"/> Yes <input type="checkbox"/> No Date <u>2-25-75</u> mo./day/yr.
Clay				90	103	14. Well head completion: <input type="checkbox"/> Pitless adapter <input type="checkbox"/> Inches above grade
Sand Rock Hard				103	108	15. Well grouted? <input checked="" type="checkbox"/> With: <input type="checkbox"/> Neat cement <input type="checkbox"/> Bentonite <input checked="" type="checkbox"/> Concrete Depth: From <u>0</u> ft. to <u>10</u> ft.
Sand Rock				108	114	16. Nearest source of possible contamination: ft. <u>14 m</u> Direction <u>SE</u> Type <u>Correl</u> Well disinfected upon completion? <input type="checkbox"/> Yes <input type="checkbox"/> No
Shale				114	145	17. Pump: <input type="checkbox"/> Not installed Manufacturer's name <u>WLR</u> Model number <u>5CM 12</u> HP <u>100</u> Volts <u>100</u> Length of drop pipe <u>205</u> ft. capacity <u>100</u> g.p.m. Type: <input type="checkbox"/> Submersible <input checked="" type="checkbox"/> Turbine <input type="checkbox"/> Jet <input type="checkbox"/> Reciprocating <input type="checkbox"/> Centrifugal <input type="checkbox"/> Other
Hard Sand rock little Shale				145	170	20. Water well contractor's certification: This well was drilled under my jurisdiction and this report is true to the best of my knowledge and belief. <u>Rosecrantz-Bemis</u> <u>134</u> Business name License No. Address <u>Great Bend, Ks.</u> Signed <u>Linda Larson</u> Date <u>4/20/76</u> Authorized representative
Good soft Sand Rock				170	233	
Hard Shale				233	255	
(Use a second sheet if needed)						
18. Elevation:		19. Remarks:				
Topography: <input type="checkbox"/> Hill <input checked="" type="checkbox"/> Slope <input type="checkbox"/> Upland <input type="checkbox"/> Valley						