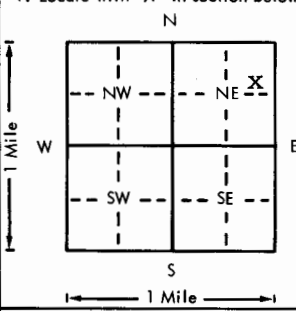


USE TYPEWRITER OR BALL POINT PEN-PRESS FIRMLY, PRINT CLEARLY.

WATER WELL RECORD  
KSA 82a-1201-1215

Kansas Department of Health and Environment-Division of Environment  
(Water well Contractors)  
Topeka, Kansas 66620

1. Location of well:	County <b>Rice</b>	Fraction <b>SE 1/4 NE 1/4 NE 1/4</b>	Section number <b>9</b>	Township number <b>T 18 S R 9</b>	Range number <b>9</b>	<b>EW</b>
2. Distance and direction from nearest town or city: <b>4 1/2 miles Southeast of Bushton, KS</b> Street address of well location if in city:			3. Owner of well: <b>Arlen Janssen</b> R.R. or street: <b>Route 2</b> City, state, zip code: <b>Geneseo, KS 67444</b>			
4. Locate with "X" in section below: Sketch map: 			6. Bore hole dia. <b>9</b> in. Completion date <b>5-26-77</b> Well depth <b>155</b> ft.			
5. Type and color of material			From		To	
Top soil			0		5	
Clay & broken limestone streaks			5		45	
Soft clay & broken limestone			45		74	
Clay			74		76	
Conglomerate			76		85	
Sandstone			85		90	
<del>Sandstone</del> Dakota Clay			90		105	
Sandstone & clay streaks			105		119	
Hard sandstone			119		120	
Sandstone & clay streaks & hard sandstone @ 140'			120		155	
(Use a second sheet if needed)						
18. Elevation:		19. Remarks:		20. Water well contractor's certification: This well was drilled under my jurisdiction and this report is true to the best of my knowledge and belief. <b>Clarke Well &amp; Eq., Inc. 185</b> Business name Address <b>Great Bend, KS 67530</b> License No. Signed <i>[Signature]</i> Date <b>6-16-77</b> Authorized representative		
Topography: ___ Hill ___ Slope ___ Upland ___ Valley						

200#  
18  
29  
9  
1/4 1/4 N 1/4