


1 LOCATION OF WATER WELL: County: Rice	Fraction NE 1/4 SE 1/4 NW 1/4	Section Number 18	Township Number T 18 S	Range Number R 9 XX EW
---	----------------------------------	----------------------	---------------------------	----------------------------------

Distance and direction from nearest town or city street address of well if located within city?
 Approx. 2 miles east and 2 miles south of Bushton

2 WATER WELL OWNER: RR#, St. Address, Box # : City, State, ZIP Code :	Norman Habiger Rural Route Bushton, KS 67427	Board of Agriculture, Division of Water Resources Application Number: not required
---	--	---

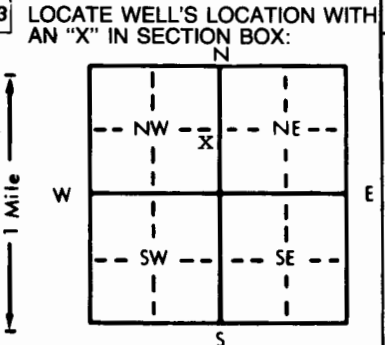

4 DEPTH OF COMPLETED WELL: 65 ft. ELEVATION: unknown
Depth(s) Groundwater Encountered 1. 25 ft. 2. ft. 3. ft.
WELL'S STATIC WATER LEVEL 25 ft. below land surface measured on mo/day/yr 11-8-84
Pump test data: Well water was not ck'd ft. after hours pumping gpm
Est. Yield unknown gpm: Well water was ft. after hours pumping gpm
Bore Hole Diameter 9 in. to 65 ft., and in. to ft.
WELL WATER TO BE USED AS: 5 Public water supply 8 Air conditioning 11 Injection well
1 Domestic 3 Feedlot 6 Oil field water supply 9 Dewatering 12 Other (Specify below)
2 Irrigation 4 Industrial 7 Lawn and garden only 10 Observation well
Was a chemical/bacteriological sample submitted to Department? Yes No X; If yes, mo/day/yr sample was submitted
Water Well Disinfected? Yes XX No

5 TYPE OF BLANK CASING USED:	5 Wrought iron	8 Concrete tile	CASING JOINTS: Glued XX Clamped	
1 Steel	3 RMP (SR)	6 Asbestos-Cement	9 Other (specify below) XXXXXXXXXXXX	
<u>2 PVC</u>	4 ABS	7 Fiberglass	Threaded	
Blank casing diameter 5 in. to 50 ft., Dia in. to ft., Dia in. to ft.				
Casing height above land surface 12 in., weight 2,277 lbs./ft. Wall thickness or gauge No. 214				
TYPE OF SCREEN OR PERFORATION MATERIAL:	7 PVC	10 Asbestos-cement		
1 Steel	3 Stainless steel	5 Fiberglass	8 RMP (SR)	11 Other (specify)
2 Brass	4 Galvanized steel	6 Concrete tile	9 ABS	12 None used (open hole)
SCREEN OR PERFORATION OPENINGS ARE:	5 Gauzed wrapped	8 Saw cut	11 None (open hole)	
1 Continuous slot	3 Mill slot	6 Wire wrapped	9 Drilled holes	
2 Louvered shutter	4 Key punched	7 Torch cut	10 Other (specify)	
SCREEN-PERFORATED INTERVALS: From 50 ft. to 65 ft., From <u>3</u> ft. to ft.				
GRAVEL PACK INTERVALS: From 25 ft. to 65 ft., From ft. to ft.				
Annular fill From 10 ft. to 21 ft., From ft. to ft.				

6 GROUT MATERIAL:	1 Neat cement	2 Cement grout	3 Bentonite	4 Other
Grout Intervals: From 0 ft. to 10 ft., From 21 ft. to 25 ft., From ft. to ft.				
What is the nearest source of possible contamination:	10 Livestock pens	14 Abandoned water well		
1 Septic tank	4 Lateral lines	7 Pit privy	11 Fuel storage	15 Oil well/Gas well
2 Sewer lines	5 Cess pool	8 Sewage lagoon	12 Fertilizer storage	16 Other (specify below)
3 Watertight sewer lines	6 Seepage pit	9 Feedyard	13 Insecticide storage	CREEK
Direction from well? East	How many feet? 100			

FROM	TO	LITHOLOGIC LOG	FROM	TO	LITHOLOGIC LOG
0	45	Topsoil & tan clay			
45	65	Sandstone - soft and clean			

7 CONTRACTOR'S OR LANDOWNER'S CERTIFICATION: This water well was (1) constructed, (2) reconstructed, or (3) plugged under my jurisdiction and was completed on (mo/day/year) 11-8-84 and this record is true to the best of my knowledge and belief. Kansas Water Well Contractor's License No. 185 This Water Well Record was completed on (mo/day/yr) 1-17-85 under the business name of Clarke Well & Eq., Inc. by (signature) <i>[Signature]</i>
INSTRUCTIONS: Use typewriter or ball point pen, PLEASE PRESS FIRMLY and PRINT clearly. Please fill in blanks, underline or circle the correct answers. Send top three copies to Kansas Department of Health and Environment, Division of Environment, Environmental Geology Section, Topeka, KS 66620. Send one to WATER WELL OWNER and retain one for your records.

OFFICE USE ONLY

T

R

EW

SEC.

1/4

1/4

1/4