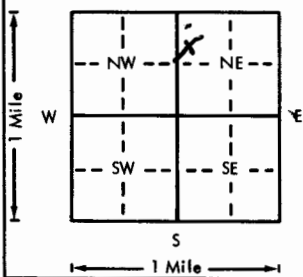


USE TYPEWRITER OR BALL POINT PEN-PRESS FIRMLY, PRINT CLEARLY.

WATER WELL RECORD
KSA 82a-1201-1215

Kansas Department of Health and Environment-Division of Environment
(Water well Contractors)
Topeka, Kansas 66620

Land #1

1. Location of well:	County <i>Rice Co.</i>	Fraction <i>SW 1/4 NW 1/4 NE 1/4</i>	Section number <i>29</i>	Township number <i>T 18 S</i>	Range number <i>R 9 W E/W</i>
2. Distance and direction from nearest town or city: <i>7 north</i>			3. Owner of well: <i>Duke Drifling Co</i>		
Street address of well location if in city: <i>1/2 east of Chase</i>			R.R. or street: <i>Great Bend Kansas</i>		
4. Locate with "X" in section below: N  W S E 1 Mile			Sketch map:		
5. Type and color of material			6. Bore hole dia. <i>4</i> in. Completion date <i>9-2-76</i> Well depth <i>110</i> ft.		
			7. <input checked="" type="checkbox"/> Cable tool <input checked="" type="checkbox"/> Rotary <input type="checkbox"/> Driven <input type="checkbox"/> Dug <input type="checkbox"/> Hollow rod <input type="checkbox"/> Jetted <input type="checkbox"/> Bored <input type="checkbox"/> Reverse rotary		
From To			8. Use: <input type="checkbox"/> Domestic <input type="checkbox"/> Public supply <input type="checkbox"/> Industry <input type="checkbox"/> Irrigation <input type="checkbox"/> Air conditioning <input type="checkbox"/> Stock <input type="checkbox"/> Lawn <input checked="" type="checkbox"/> Oil field water <input type="checkbox"/> Other		
			9. Casing: Material <i>PVC</i> Height: Above or below Threaded <input type="checkbox"/> Welded <input checked="" type="checkbox"/> Surface <i>12</i> in. RMP <input type="checkbox"/> PVC <input checked="" type="checkbox"/> Weight _____ lbs./ft. Dia. <i>4</i> in. to <i>110</i> ft. depth Wall Thickness: inches or Dia. _____ in. to _____ ft. depth gage No. <i>200</i>		
5. Type and color of material			10. Screen: Manufacturer's name _____ Type <i>RDC</i> Dia. <i>4</i> Slot/gauze <i>1/8</i> Length <i>20</i> Set between <i>90</i> ft. and <i>110</i> ft. _____ ft. and _____ ft. Gravel pack? <input checked="" type="checkbox"/> Size range of material <i>1/4-1/8</i>		
			11. Static water level: _____ mo./day/yr. <i>26</i> ft. below land surface Date <i>9-3-76</i>		
5. Type and color of material			12. Pumping level below land surfaces: <i>40</i> ft. after <i>1</i> hrs. pumping <i>100</i> g.p.m. _____ ft. after _____ hrs. pumping _____ g.p.m. Estimated maximum yield <i>200</i> g.p.m.		
			13. Water sample submitted: _____ mo./day/yr. Yes <input checked="" type="checkbox"/> No <input type="checkbox"/> Date _____		
5. Type and color of material			14. Well head completion: <input type="checkbox"/> Pitless adapter <i>12</i> Inches above grade		
			<input checked="" type="checkbox"/> Well grouted? <input checked="" type="checkbox"/> With: <input type="checkbox"/> Neat cement <input checked="" type="checkbox"/> Bentonite <input type="checkbox"/> Concrete Depth: From <i>10</i> ft. to <i>0</i> ft.		
5. Type and color of material			16. Nearest source of possible contamination: ft. _____ Direction _____ Type _____ Well disinfected upon completion? <input type="checkbox"/> Yes <input type="checkbox"/> No		
			17. Pump: <input checked="" type="checkbox"/> Not installed Manufacturer's name _____ Model number _____ HP _____ Volts _____ Length of drop pipe _____ ft. capacity _____ g.p.m. Type: <input type="checkbox"/> Submersible <input type="checkbox"/> Turbine <input type="checkbox"/> Jet <input type="checkbox"/> Reciprocating <input type="checkbox"/> Centrifugal <input type="checkbox"/> Other		
18. Elevation:			20. Water well contractor's certification: This well was drilled under my jurisdiction and this report is true to the best of my knowledge and belief. <i>Myles White Well</i> Business name _____ License No. <i>173</i> Address <i>Great Bend KS</i> Signed _____ Date _____ Authorized representative		
19. Remarks:			20. Water well contractor's certification: This well was drilled under my jurisdiction and this report is true to the best of my knowledge and belief. <i>Myles White Well</i> Business name _____ License No. <i>173</i> Address <i>Great Bend KS</i> Signed _____ Date _____ Authorized representative		

18-29-76
E
29
SW
1/4
1/4
1/4