


USE TYPEWRITER OR BALL POINT PEN-PRESS FIRMLY, PRINT CLEARLY.

WATER WELL RECORD
KSA 82a-1201-1215

Kansas Department of Health and Environment-Division of Environment
(Water well Contractors)
Topeka, Kansas 66620

1. Location of well: County Mepherson Fraction NW 1/4 NW 1/4 NE 1/4 Section number 2 Township number T 19 S Range number R 1 E W

2. Distance and direction from nearest town or city: 3 N 1 1/2 E
Street address of well location if in city: Canton
3. Owner of well: Orville Koch
R.R. or street: BRI
City, state, zip code: Canton, Mo. 67428

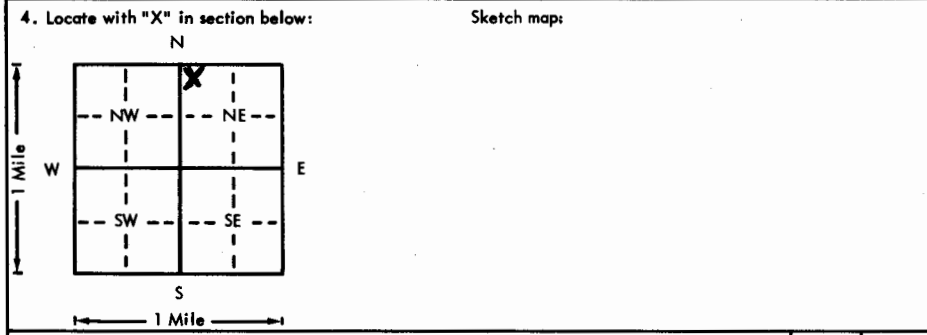

6. Bore hole dia. 2 in. Completion date _____
Well depth 100 ft.
7. Cable tool Rotary Driven Dug
 Hollow rod Jetted Bored Reverse rotary
8. Use: Domestic Public supply Industry
 Irrigation Air conditioning Stock
 Lawn Oil field water Other
9. Casing: Material PVC Height: Above or below
Threaded Welded Surface 12 in.
RMP 5 PVC Weight 140 lbs./ft.
Dia. 5 in. to 100 ft. depth Wall Thickness: inches or
Dia. _____ in. to _____ ft. depth Gage No. 1224

5. Type and color of material	From	To
<u>Sand Rock</u>	<u>0</u>	<u>4</u>
<u>Sandy Clay</u>	<u>4</u>	<u>35</u>
<u>fine Sand</u>	<u>35</u>	
<u>yellow Clay</u>	<u>35</u>	<u>42</u>
<u>Blue Shale</u>	<u>42</u>	<u>82</u>
<u>Some water</u>	<u>82</u>	
<u>Blue Shale</u>	<u>82</u>	<u>100</u>
(Use a second sheet if needed)		

10. Screen: Manufacturer's name Pumpco
Type PVC Dia. 5
Slot/gauze 30 Length 30
Set between 20 ft. and 40 ft.
20 ft. and 40 ft.
Gravel pack? Size range of material 30
11. Static water level: _____ mo./day/yr.
30 ft. below land surface Date 5-20-76
12. Pumping level below land surfaces:
_____ ft. after _____ hrs. pumping _____ g.p.m.
_____ ft. after _____ hrs. pumping _____ g.p.m.
Estimated maximum yield _____ g.p.m.
13. Water sample submitted: _____ mo./day/yr.
Yes No Date _____
14. Well head completion:
 Pitless adapter _____ Inches above grade
15. Well grouted?
With: _____ Neat cement _____ Bentonite Concrete
Depth: From 3 ft. to 13 ft.
16. Nearest source of possible contamination: _____ ft. _____ Direction W Type tank
Well disinfected upon completion? Yes No
17. Pump: Not installed
Manufacturer's name _____
Model number _____ HP _____ Volts _____
Length of drop pipe _____ ft. capacity _____ g.p.m.
Type:
 Submersible Turbine
 Jet Reciprocating
 Centrifugal Other

18. Elevation:
Topography:
 Hill
 Slope
 Upland
 Valley

19. Remarks: Customer to run concrete slab around well, Pump not installed by my company

20. Water well contractor's certification:
This well was drilled under my jurisdiction and this report is true to the best of my knowledge and belief.
Backus Drg. 180
Business name _____ License No. _____
Address Jampa to 67428
Signed Paul Backus Date 5/20/76
Authorized representative

19-10-2 NW 1/4 NE