


USE TYPEWRITER OR BALL POINT PEN-PRESS FIRMLY, PRINT CLEARLY.

WATER WELL RECORD
KSA 82a-1201-1215

Kansas Department of Health and Environment-Division of Environment (Water well Contractors) Topeka, Kansas 66620

1. Location of well: County McPherson Fraction SE 1/4 SE 1/4 SE 1/4 Section number 6 Township number T 19 Range number S R 1 NW

2. Distance and direction from nearest town or city: ~~XXXXXXXXXX~~ 3 E 3 N
Street address of well location if in city: of Galva Kan
3. Owner of well: STEVE SCHMIOT
R.R. or street: Box 232 Canton Kan
City, state, zip code: 07428

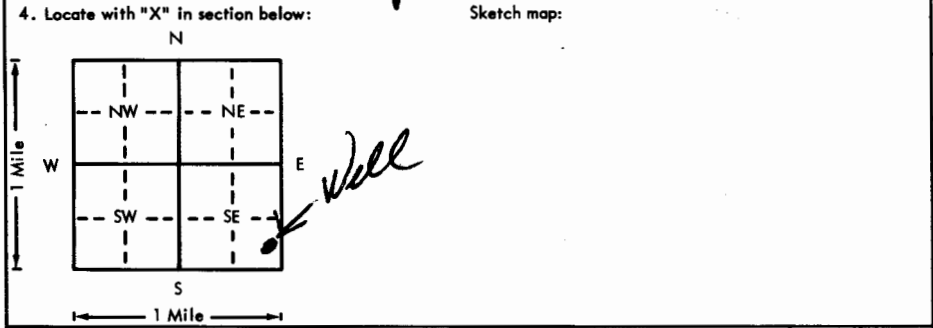

6. Bore hole dia. 8 in. Completion date 10-21
Well depth 49 ft. 76
7. Cable tool Rotary Driven Dug
 Hollow rod Jetted Bored Reverse rotary
8. Use: Domestic Public supply Industry
 Irrigation Air conditioning Stock
 Lawn Oil field water Other
 Casing: Material PVC Height: Above or below
Threaded Welded Surface 12 in.
RMP PVC Weight lbs./ft.
Dia. 4 in. to 48 ft. depth Wall Thickness: inches or
Dia. in. to ft. depth gage No. 200

5. Type and color of material	From	To
Top soil	0	2
CLAY - RED	2	16
CLAY - PINK	16	25
CLAY - BUFF	25	31
V. FINE - SAND - + CLAY mix	31	39
SAND - MEDIUM	39	45
CLAY - BUFF	45	47
47 FT. CASED. WELL		
(Use a second sheet if needed)		

10. Screen: Manufacturer's name CENTERTED
Type PVC Dia. 4"
Slot/gauze 1/16 Length 10 ft
Set between 38 ft. and 48 ft.
Gravel pack? yes Size range of material 1/4"
11. Static water level: 26 ft. below land surface Date 10-21-76 mo./day/yr.
12. Pumping level below land surfaces:
32 ft. after 1 hrs. pumping 10 g.p.m.
 ft. after hrs. pumping g.p.m.
Estimated maximum yield 20 g.p.m.
13. Water sample submitted: mo./day/yr.
Yes No Date
14. Well head completion:
 Pitless adapter inches above grade
15. Well grouted? yes
With: Neat cement Bentonite Concrete
Depth: From 6 ft. to 10 ft.
 Nearest source of possible contamination:
ft. Direction Type
Well disinfected upon completion? Yes No
17. Pump: Not installed
Manufacturer's name
Model number HP Volts
Length of drop pipe ft. capacity g.p.m.
Type:
 Submersible Turbine
 Jet Reciprocating
 Centrifugal Other

18. Elevation:
Topography: Hill Slope Upland Valley
19. Remarks: WELL WILL BE IN BASEMENT WHEN FINISHED.

20. Water well contractor's certification:
This well was drilled under my jurisdiction and this report is true to the best of my knowledge and belief.
Peterson Bros Inc. 138A
Business name Box 150 Lincoln License No.
Address
Signed Walter Peterson Date 11-17-76
Authorized representative

179 T-1-W-10 SE SE SE