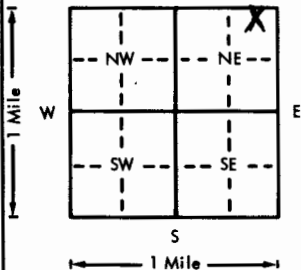


USE TYPEWRITER OR BALL POINT PEN-PRESS FIRMLY, PRINT CLEARLY.

WATER WELL RECORD
KSA 82a-1201-1215

Kansas Department of Health and Environment-Division of Environment
(Water well Contractors)
Topeka, Kansas 66620

1. Location of well: County <u>Madison</u> Fraction <u>NE 1/4 NE 1/4 NE 1/4</u> Section number <u>7</u> Township number <u>T 19 S R 1</u> Range number <u>1</u> EAW	
2. Distance and direction from nearest town or city: <u>2 W 3 N 4 W</u> Street address of well location if in city: <u>Canton</u> 3. Owner of well: <u>Irby Weibel</u> R.R. or street: <u>RR 1</u> City, state, zip code: <u>Canton, KS 67428</u>	
4. Locate with "X" in section below: Sketch map: 	
5. Type and color of material	
	From To
<u>Top Soil</u>	<u>0 2</u>
<u>Yellow Clay</u>	<u>2 22</u>
<u>Sandy Clay</u>	<u>22 35</u>
<u>fine Sand</u>	<u>35 45</u>
<u>Bed Clay</u>	<u>45 55</u>
<u>Medium Sand</u>	<u>55 65</u>
<u>Bed Shale</u>	<u>65</u>
(Use a second sheet if needed)	
18. Elevation:	19. Remarks:
Topography: <input type="checkbox"/> Hill <input type="checkbox"/> Slope <input checked="" type="checkbox"/> Upland <input type="checkbox"/> Valley	20. Water well contractor's certification: This well was drilled under my jurisdiction and this report is true to the best of my knowledge and belief. <u>Backhus Dig 180</u> Business name: <u>Tampa, KS</u> License No. _____ Address: <u>Tampa, KS</u> Signed: <u>Paul Backhus</u> Date: <u>9-10-76</u> Authorized representative

6. Bore hole dia. <u>8</u> in. Completion date <u>9-10-76</u> Well depth <u>68</u> ft.
7. <input checked="" type="checkbox"/> Cable tool <input checked="" type="checkbox"/> Rotary <input type="checkbox"/> Driven <input type="checkbox"/> Dug <input type="checkbox"/> Hollow rod <input type="checkbox"/> Jetted <input type="checkbox"/> Bored <input type="checkbox"/> Reverse rotary
8. Use: <input checked="" type="checkbox"/> Domestic <input type="checkbox"/> Public supply <input type="checkbox"/> Industry <input type="checkbox"/> Irrigation <input type="checkbox"/> Air conditioning <input type="checkbox"/> Stock <input type="checkbox"/> Lawn <input type="checkbox"/> Oil field water <input type="checkbox"/> Other
9. Casing: Material <u>PVC</u> Height: <u>92</u> or below Threaded <input type="checkbox"/> Welded <input type="checkbox"/> Surface <u>92</u> in. RMP <input type="checkbox"/> PVC <input checked="" type="checkbox"/> Weight: <u>6440</u> lbs./ft. Dia. <u>5</u> in. to <u>6 1/2</u> ft. depth Wall Thickness: inches of <u>1.250</u> Dia. <u>5</u> in. to <u>6 1/2</u> ft. depth gage No. <u>1250</u>
10. Screen: Manufacturer's name <u>Certain teed</u> Type <u>PVC</u> Dia. <u>5 1/2</u> Slot/gauze <u>10</u> Length <u>10</u> Set between <u>3.5</u> ft. and <u>6.5</u> ft. Gravel pack? <input checked="" type="checkbox"/> Size range of material <u>4-10</u> ft.
11. Static water level: <u>43</u> ft. below land surface Date <u>9-10-76</u> mo./day/yr.
12. Pumping level below land surfaces: ____ ft. after ____ hrs. pumping ____ g.p.m. ____ ft. after ____ hrs. pumping ____ g.p.m. Estimated maximum yield ____ g.p.m.
13. Water sample submitted: <input checked="" type="checkbox"/> Yes <input type="checkbox"/> No Date _____ mo./day/yr.
14. Well head completion: <input type="checkbox"/> Pitless adapter <u>12</u> inches above grade
15. Well grouted? <input checked="" type="checkbox"/> With: <input type="checkbox"/> Neat cement <input type="checkbox"/> Bentonite <input checked="" type="checkbox"/> Concrete Depth: From <u>0</u> ft. to <u>10</u> ft.
16. Nearest source of possible contamination: <u>septic</u> ft. <u>70</u> Direction <u>S</u> Type <u>tank</u> Well disinfected upon completion? <input checked="" type="checkbox"/> Yes <input type="checkbox"/> No
17. Pump: <input checked="" type="checkbox"/> Not installed Manufacturer's name _____ Model number _____ HP _____ Volts _____ Length of drop pipe _____ ft. capacity _____ g.p.m. Type: <input type="checkbox"/> Submersible <input type="checkbox"/> Turbine <input type="checkbox"/> Jet <input type="checkbox"/> Reciprocating <input type="checkbox"/> Centrifugal <input type="checkbox"/> Other

T 19 S R 1
NE 1/4 NE 1/4 NE 1/4