


1 LOCATION OF WATER WELL: Fraction ne 1/4 se 1/4 ne 1/4 Section Number 9 Township Number T 19 S Range Number R 9 EW

County: Moberly Distance and direction from nearest town or city street address of well if located within city?  
1 1/4 N Canton

2 WATER WELL OWNER: Dennis Wedel Board of Agriculture, Division of Water Resources  
 RR#, St. Address, Box #: RR 1 Application Number:  
 City, State, ZIP Code: Canton Mo. 67428

3 LOCATE WELL'S LOCATION WITH AN "X" IN SECTION BOX:

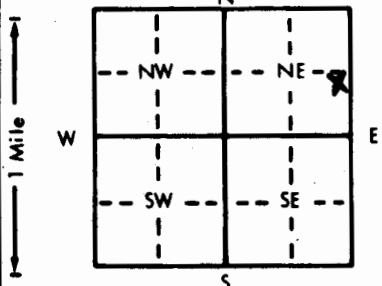

4 DEPTH OF COMPLETED WELL: 162 ft. ELEVATION:

Depth(s) Groundwater Encountered 1. .... ft. 2. .... ft. 3. .... ft.  
 WELL'S STATIC WATER LEVEL: 50 ft. below land surface measured on 8-14-81  
 Pump test data: Well water was ..... ft. after ..... hours pumping ..... gpm  
 Est. Yield 4 gpm: Well water was ..... ft. after ..... hours pumping ..... gpm  
 Bore Hole Diameter: 9 in. to 20 ft., and 7 in. to 162 ft.  
 WELL WATER TO BE USED AS:  
 5 Public water supply 8 Air conditioning 11 Injection well  
 1 Domestic 3 Feedlot 6 Oil field water supply 9 Dewatering 12 Other (Specify below)  
 2 Irrigation 4 Industrial 7 Lawn and garden only 10 Observation well  
 Was a chemical/bacteriological sample submitted to Department? Yes..... No X.....; If yes, mo/day/yr sample was submitted  
 Water Well Disinfected? Yes X No

5 TYPE OF BLANK CASING USED: 5 Wrought iron 8 Concrete tile CASING JOINTS: Glued X Clamped  
 1 Steel 3 RMP (SR) 6 Asbestos-Cement 9 Other (specify below) Welded  
 2 PVC 4 ABS 7 Fiberglass Threaded

Blank casing diameter: 5 in. to 22 ft., Dia. 5 in. to 132 ft., Dia. .... in. to .... ft.  
 Casing height above land surface: 12 in., weight 160 lbs./ft. Wall thickness or gauge No. 160

TYPE OF SCREEN OR PERFORATION MATERIAL:  
 1 Steel 3 Stainless steel 5 Fiberglass 8 RMP (SR) 10 Asbestos-cement  
 2 Brass 4 Galvanized steel 6 Concrete tile 9 ABS 11 Other (specify) .....  
 12 None used (open hole)

SCREEN OR PERFORATION OPENINGS ARE:  
 1 Continuous slot 3 Mill slot 5 Gauzed wrapped 8 Saw cut 11 None (open hole)  
 2 Louvered shutter 4 Key punched 6 Wire wrapped 9 Drilled holes  
 7 Torch cut 10 Other (specify) .....

SCREEN-PERFORATED INTERVALS: From 22 ft. to 32 ft., From ..... ft. to ..... ft.  
 From 132 ft. to 162 ft., From ..... ft. to ..... ft.  
 GRAVEL PACK INTERVALS: From 10 ft. to 162 ft., From ..... ft. to ..... ft.  
 From ..... ft. to ..... ft., From ..... ft. to ..... ft.

6 GROUT MATERIAL: 1 Neat cement 2 Cement grout 3 Bentonite 4 Other .....  
 Grout Intervals: From 0 ft. to 10 ft., From ..... ft. to ..... ft., From ..... ft. to ..... ft.

What is the nearest source of possible contamination:  
 1 Septic tank 4 Lateral lines 7 Pit privy 10 Livestock pens 14 Abandoned water well  
 2 Sewer lines 5 Cess pool 8 Sewage lagoon 11 Fuel storage 15 Oil well/Gas well  
 3 Watertight sewer lines 6 Seepage pit 9 Feedyard 12 Fertilizer storage 16 Other (specify below)  
 13 Insecticide storage  
 Direction from well? S How many feet? 50+

FROM	TO	LITHOLOGIC LOG	FROM	TO	LITHOLOGIC LOG
0	2	Top Soil			
2	22	Clay			
22	27	fine Sand			
27	150	Blue Shale			
150	157	Some Water			
157	162	Blue Shale			

7 CONTRACTOR'S OR LANDOWNER'S CERTIFICATION: This water well was (1) constructed, (2) reconstructed, or (3) plugged under my jurisdiction and was completed on (mo/day/year) 8-20-81 and this record is true to the best of my knowledge and belief. Kansas Water Well Contractor's License No. 100 This Water Well Record was completed on (mo/day/yr) 8-20-81 under the business name of Bachhus Drilling by signature Paul Peathus

INSTRUCTIONS: Use typewriter or ball point pen, PLEASE PRESS FIRMLY and PRINT clearly. Please fill in blanks, underline or circle the correct answers. Send top three copies to Kansas Department of Health and Environment, Division of Environment, Environmental Geology Section, Topeka, KS 66620. Send one to WATER WELL OWNER and retain one for your records.