


USE TYPEWRITER OR BALL POINT PEN-PRESS FIRMLY, PRINT CLEARLY.

WATER WELL RECORD
KSA 82a-1201-1215

Kansas Department of Health and Environment-Division of Environment (Water well Contractors) Topeka, Kansas 66620

1. Location of well: County McPherson Fraction NW 1/4 NE 1/4 NE 1/4 Section number 19 Township number T 19 S R 1 Range number 1 (W)

2. Distance and direction from nearest town or city: 2 1/4 mi. W. of
Street address of well location if in city: CANTON, KS.
3. Owner of well: DONALD DRESHER
R.R. or street: R.R. # 1 CANTON, KS. 67428
City, state, zip code: CANTON, KS. 67428

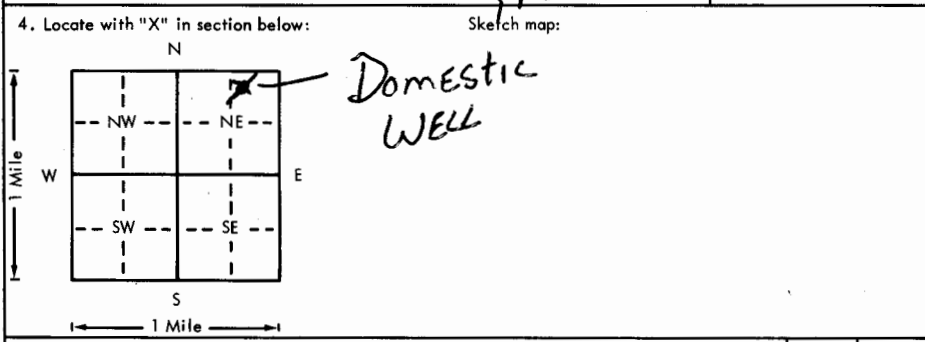

6. Bore hole dia. 8 in. Completion date 10-9-78
Well depth 75 ft.

7. Cable tool Rotary Driven Dug
 Hollow rod Jetted Bored Reverse rotary

8. Use: Domestic Public supply Industry
 Irrigation Air conditioning Stock
 Lawn Oil field water Other

9. Casing: Material Height: Above or below
Threaded Welded Surface 24 in.
RMP PVC Weight 2 lbs./ft.
Dia. 4 in. to 55 ft. depth Wall Thickness: inches or
Dia. in. to ft. depth gage No. 25

5. Type and color of material	From	To
Top Soil	0	5
BROWN CLAY	5	10
VERY FINE GRAY SAND	10	25
BROWN CLAY AND VERY FINE SAND	25	40
VERY FINE BROWN SAND	40	55
MEDIUM BROWN SAND	55	65
BLUE SHALE	65	75
(Use a second sheet if needed)		

10. Screen: Manufacturer's name PEERLESS PLASTICS
Type PVC Dia. 4"
Slot/gauze 1/16 Length 20ft
Set between 55 ft. and 75 ft.
Set between ft. and ft.
Gravel pack? Size range of material 1/4 in

11. Static water level: 25 ft. below land surface Date 10-9-78 mo./day/yr.

12. Pumping level below land surfaces:
30 ft. after 2 hrs. pumping 10 g.p.m.
 ft. after hrs. pumping g.p.m.
Estimated maximum yield 20 g.p.m.

13. Water sample submitted: mo./day/yr.
 Yes No Date

14. Well head completion:
 Pitless adapter 24 Inches above grade

15. Well grouted? YES
With: Neat cement Bentonite Concrete
Depth: From 0 ft. to 10 ft.

16. Nearest source of possible contamination: CATTLE
ft. 150 Direction South Type Surface
Well disinfected upon completion? Yes No

17. Pump: Not installed
Manufacturer's name
Model number HP Volts
Length of drop pipe ft. capacity g.p.m.
Type:
 Submersible Turbine
 Jet Reciprocating
 Centrifugal Other

18. Elevation:
Topography:
 Hill
 Slope
 Upland
 Valley

19. Remarks:

20. Water well contractor's certification:
This well was drilled under my jurisdiction and this report is true to the best of my knowledge and belief.
PETERSON IRRIGATION 138
Business name License No.
Address Box 159 LINOSBAK, KS
Signed Mike Peterson Date 11-3-78
Authorized representative

T 19
R 19
E 19
S 19
NW NE
1/4 1/4 1/4