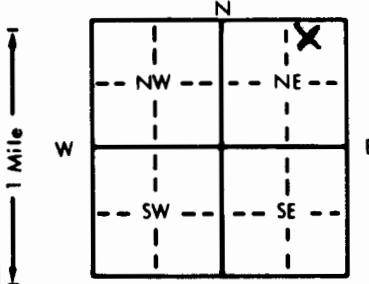


1 LOCATION OF WATER WELL: Fraction NW 1/4 NE 1/4 NE 1/4 Section Number 19 Township Number T 19 S Range Number R 1 EWP
 County: Mapherson

Distance and direction from nearest town or city street address of well if located within city?
2 1/4 W Canton

2 WATER WELL OWNER: Donald Dresher Board of Agriculture, Division of Water Resources
 RR#, St. Address, Box #: RR1 Application Number:
 City, State, ZIP Code: Canton, KS. 67428

3 LOCATE WELL'S LOCATION WITH AN "X" IN SECTION BOX:

 4 DEPTH OF COMPLETED WELL: 45 ft. ELEVATION:
 Depth(s) Groundwater Encountered 1. 38 ft. 2. _____ ft. 3. _____ ft.
 WELL'S STATIC WATER LEVEL 2.3 ft. below land surface measured on mo/day/yr 10-28-91
 Pump test data: Well water was _____ ft. after _____ hours pumping _____ gpm
 Est. Yield 20 gpm: Well water was _____ ft. after _____ hours pumping _____ gpm
 Bore Hole Diameter 9 in. to 45 ft., and _____ in. to _____ ft.
 WELL WATER TO BE USED AS: 5 Public water supply 8 Air conditioning 11 Injection well
 1 Domestic 3 Feedlot 6 Oil field water supply 9 Dewatering 12 Other (Specify below)
 2 Irrigation 4 Industrial 7 Lawn and garden only 10 Monitoring well
 Was a chemical/bacteriological sample submitted to Department? Yes _____ No If yes, mo/day/yr sample was submitted _____
 Water Well Disinfected? Yes No _____

5 TYPE OF BLANK CASING USED:
 1 Steel 3 RMP (SR) 5 Wrought iron 8 Concrete tile CASING JOINTS: Glued Clamped _____
 2 PVC 4 ABS 6 Asbestos-Cement 9 Other (specify below) Welded _____
 7 Fiberglass _____ Threaded _____
 Blank casing diameter 5 in. to 35 ft., Dia _____ in. to _____ ft., Dia _____ in. to _____ ft.
 Casing height above land surface 12 in., weight Class 160 lbs./ft. Wall thickness or gauge No. 214
 TYPE OF SCREEN OR PERFORATION MATERIAL:
 1 Steel 3 Stainless steel 5 Fiberglass 7 PVC 10 Asbestos-cement
 2 Brass 4 Galvanized steel 6 Concrete tile 8 RMP (SR) 11 Other (specify) _____
 9 ABS 12 None used (open hole)
 SCREEN OR PERFORATION OPENINGS ARE:
 5 Gauzed wrapped 8 Saw cut 11 None (open hole)
 1 Continuous slot 3 Mill slot 6 Wire wrapped 9 Drilled holes
 2 Louvered shutter 4 Key punched 7 Torch cut 10 Other (specify) _____
 SCREEN-PERFORATED INTERVALS: From 35 ft. to 45 ft., From _____ ft. to _____ ft.
 From _____ ft. to _____ ft., From _____ ft. to _____ ft.
 GRAVEL PACK INTERVALS: From 23 ft. to 45 ft., From _____ ft. to _____ ft.
 From _____ ft. to _____ ft., From _____ ft. to _____ ft.

6 GROUT MATERIAL: 3 Neat cement 2 Cement grout 3 Bentonite 4 Other _____
 Grout Intervals: From 3 ft. to 23 ft., From _____ ft. to _____ ft., From _____ ft. to _____ ft.
 What is the nearest source of possible contamination:
 1 Septic tank 4 Lateral lines 7 Pit privy 10 Livestock pens 14 Abandoned water well
 2 Sewer lines 5 Cess pool 8 Sewage lagoon 11 Fuel storage 15 Oil well/Gas well
 3 Watertight sewer lines 6 Seepage pit 9 Feedyard 12 Fertilizer storage 16 Other (specify below)
 13 Insecticide storage _____
 Direction from well? S W How many feet? 50+

FROM	TO	LITHOLOGIC LOG	FROM	TO	PLUGGING INTERVALS
0	24	Clay			
24	32	fine Sand			
32	41	Clay			
41	43	Sand			
43	45	Clay + Red Sand Stone			

7 CONTRACTOR'S OR LANDOWNER'S CERTIFICATION: This water well was (1) constructed (2) ~~reconstructed~~, or (3) plugged under my jurisdiction and was completed on (mo/day/year) 10-28-91 and this record is true to the best of my knowledge and belief. Kansas Water Well Contractor's License No. 120 This Water Well Record was completed on (mo/day/yr) 11-13-91 under the business name of Backhue Drilling by (signature) [Signature]