


1 LOCATION OF WATER WELL: County: McPherson		Fraction NW ¼ NW ¼ SW ¼	Section Number 22	Township Number T 19 S	Range Number R 1 E
--	--	----------------------------	----------------------	---------------------------	-----------------------

Distance and direction from nearest town or city street address of well if located within city?  
209 S Main Street, Canton, ks. MW #1

2	WATER WELL OWNER:	The Canton Elevator	
	RR#, St. Address, Box # :	209 S Main St.	Board of Agriculture, Division of Water Resources
	City, State, ZIP Code :	Canton, Ks. 67428	Application Number:

3 LOCATE WELL'S LOCATION WITH AN "X" IN SECTION BOX: 4 DEPTH OF COMPLETED WELL: 50 ft. ELEVATION:   
 Depth(s) Groundwater Encountered 1. 3.5 ft. 2. ft. 3. ft.

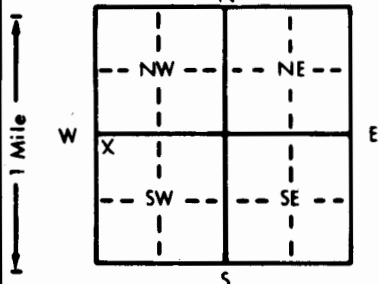

4 DEPTH OF COMPLETED WELL ..... 50 ..... ft. ELEVATION: .....  
 Depth(s) Groundwater Encountered 1. 35 ..... ft. 2. .... ft. 3. .... ft.  
 WELL'S STATIC WATER LEVEL ..... 33.33 ft. below land surface measured on mo/day/yr 2-19-92 .....  
 Pump test data: Well water was ..... ft. after ..... hours pumping ..... gpm  
 Est. Yield ..... gpm: Well water was ..... ft. after ..... hours pumping ..... gpm  
 Bore Hole Diameter ..... 7 5/8 in. to ..... 5.0 ..... ft., and ..... in. to ..... ft.  
 WELL WATER TO BE USED AS: 5 Public water supply 8 Air conditioning 11 Injection well  
 1 Domestic 3 Feedlot 6 Oil field water supply 9 Dewatering 12 Other (Specify below)  
 2 Irrigation 4 Industrial 7 Lawn and garden only 10 Monitoring well .....  
 Was a chemical/bacteriological sample submitted to Department? Yes ..... No .....; If yes, mo/day/yr sample was submitted .....  
 Water Well Disinfected? Yes ..... No .....

5 TYPE OF BLANK CASING USED:		5 Wrought iron	8 Concrete tile	CASING JOINTS: Glued . . . . . Clamped . . . . .	
1 Steel	3 RMP (SR)	6 Asbestos-Cement	9 Other (specify below)	Welded . . . . .	
② PVC	4 ABS	7 Fiberglass		Threaded . . . . . <input checked="" type="checkbox"/>	
Blank casing diameter . . . . . 2 . . . . . in. to . . . . . 3.0 . . . . . ft., Dia				in. to . . . . . ft., Dia	
Casing height above land surface . . . . . 0 . . . . . in., weight . . . . . lbs./ft.				Wall thickness or gauge No. Sch 40	

TYPE OF SCREEN OR PERFORATION MATERIAL:			7 PVC	10 Asbestos-cement
1 Steel	3 Stainless steel	5 Fiberglass	8 RMP (SR)	11 Other (specify) . . . . .
2 Brass	4 Galvanized steel	6 Concrete tile	9 ABS	12 None used (open hole)

SCREEN OR PERFORATION OPENINGS ARE:

1 Continuous slot	③ Mill slot	5 Gauzed wrapped	8 Saw cut	11 None (open hole)
2 Louvered shutter	4 Key punched	6 Wire wrapped	9 Drilled holes	
		7 Torch cut	10 Other (specify) .....	

SCREEN-PERFORATED INTERVALS:	From . . . . . 30 . . . . .	ft. to . . . . . 50 . . . . .	ft., From . . . . .	ft. to . . . . .	ft.
	From . . . . .	ft. to . . . . .	ft., From . . . . .	ft. to . . . . .	ft.
GRAVEL PACK INTERVALS:	From . . . . . 28 . . . . .	ft. to . . . . . 50 . . . . .	ft., From . . . . .	ft. to . . . . .	ft.
	From . . . . .	ft. to . . . . .	ft., From . . . . .	ft. to . . . . .	ft.

6] GROUT MATERIAL: ① Neat cement 2 Cement grout ③ Bentonite 4 Other .....  
Grout Intervals: From ... 0 ft. to ... 2.5 ft., From ... 2.5 ft. to ... 28 (bent.) ft. to ... ft.  
What is the nearest source of possible contamination:  
1 Septic tank 4 Lateral lines 7 Pit privy 10 Livestock pens 14 Abandoned water well  
2 Sewer lines 5 Cess pool 8 Sewage lagoon ① Fuel storage 15 Oil well/Gas well  
3 Watertight sewer lines 6 Seepage pit 9 Feedyard 12 Fertilizer storage 16 Other (specify below)  
13 Insecticide storage .....  
Direction from well? Within excavation How many feet? 0

[illegible]

7 CONTRACTOR'S OR LANDOWNER'S CERTIFICATION: This water well was (1) constructed, (2) reconstructed, or (3) plugged under my jurisdiction and was completed on (mo/day/year) 2-15-92 and this record is true to the best of my knowledge and belief. Kansas Water Well Contractor's License No. 527 This Water Well Record was completed on (mo/day/yr) 2-26-92 under the business name of GeoCore Services, Inc. by (signature) Dale A. Bell