


1	LOCATION OF WATER WELL: County: McPherson	Fraction SE ¼ NE ¼ NE ¼	Section Number 29	Township Number T 19 S	Range Number R 1 E
---	---	---	-----------------------------	----------------------------------	------------------------------

Distance and direction from nearest town or city street address of well if located within city?
1 mile west and $\frac{1}{4}$ So. of Canton, Kansas

2 WATER WELL OWNER:	Ellwood Koehn	
RR#, St. Address, Box # :	R. R. #2	Board of Agriculture, Division of Water Resources
City, State, ZIP Code :	Canton, Kansas	Application Number: 182-657

LOCATE WELL'S LOCATION WITH AN "X" IN SECTION BOX: 4 DEPTH OF COMPLETED WELL: 12 ft. ELEVATION: 12
 Depth(s) Groundwater Encountered 1 48 ft. 2. ft. 3. ft.

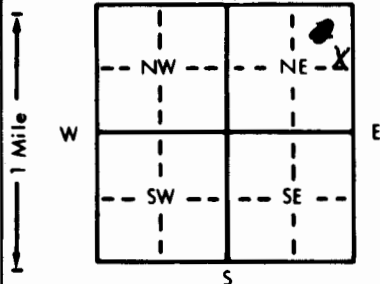







WELL WATER TO BE USED AS:

1 Domestic	3 Feedlot	5 Public water supply	8 Air conditioning	11 Injection well
2 Irrigation	4 Industrial	6 Oil field water supply	9 Dewatering	12 Other (Specify below)
		7 Lawn and garden only	10 Observation well	

Was a chemical/bacteriological sample submitted to Department? Yes.....No.....XX; If yes, mo/day/yr sample was sub
mitted Water Well Disinfected? Yes XX No

5	TYPE OF BLANK CASING USED:	5 Wrought iron	8 Concrete tile	CASING JOINTS: Glued XX Clamped
	1 Steel	6 Asbestos-Cement	9 Other (specify below)	Welded
XX	2 PVC	7 Fiberglass		Threaded
	3 RMP (SR)			
	4 ABS			

Blank casing diameter 3 in. to 72 ft. Dia in. to ft. Dia in. to ft.
Casing height above land surface 12 in. weight .91 lbs./ft. Wall thickness or gauge No. .135

TYPE OF SCREEN OR PERFORATION MATERIAL:				
1 Steel	3 Stainless steel	5 Fiberglass	7 PVC	10 Asbestos-cement
2 Brass	4 Galvanized steel	6 Concrete tile	8 RMP (SR)	11 Other (specify)
			9 ABS	12 None used (open hole)

SCREEN OR PERFORATION OPENINGS ARE:		5 Gauzed wrapped	8 Saw cut	11 None (open hole)
1 Continuous slot	3 Mill slot	6 Wire wrapped	9 Drilled holes	
2 Louvered shutter	4 Key punched	7 Torch cut	10 Other (specify)	

SCREEN-PERFORATED INTERVALS:	From . . . 32 ft. to . . . 72 ft.,	From ft. to ft.
	From ft. to ft.,	From ft. to ft.
GRAVEL PACK INTERVALS:	From . . . 15 ft. to . . . 72 ft.,	From ft. to ft.
	From ft. to ft.,	From ft. to ft.

6] GROUT MATERIAL: ☒ Neat cement ☐ 2 Cement grout ☐ 3 Bentonite ☐ 4 Other _____

Grout Intervals: From 5 ft. to 15 ft., From _____ ft. to _____ ft., From _____ ft. to _____ ft.

What is the nearest source of possible contamination:				10 Livestock pens	14 Abandoned water well
1 Septic tank	4 Lateral lines	7 Pit privy	11 Fuel storage	XX 15 Oil well/Gas well	
2 Sewer lines	5 Cess pool	8 Sewage lagoon	12 Fertilizer storage	16 Other (specify below)	
3 Watertight sewer lines	6 Seepage pit	9 Feedyard	13 Insecticide storage		
Direction from well? east			How many feet?	80	

[illegible]

7 CONTRACTOR'S OR LANDOWNER'S CERTIFICATION: This water well was (1) constructed, (2) reconstructed, or (3) plugged under my jurisdiction and was completed on (mo/day/year) 12-15-82 and this record is true to the best of my knowledge and belief. Kansas Water Well Contractor's License No. 183 This Water Well Record was completed on (mo/day/yr) 12-20-82 under the business name of Peterson Irrigation Inc. by (signature) Mike Peterson

INSTRUCTIONS: Use typewriter or ball point pen, PLEASE PRESS FIRMLY and PRINT clearly. Please fill in blanks, underline or circle the correct answers. Send top three copies to Kansas Department of Health and Environment, Division of Environment, Environmental Geology Section, Topeka, KS 66620. Send one to WATER WELL OWNER and retain one for your records.