


Distance and direction from nearest town or city street address of well if located within city?

2 WATER WELL OWNER: Robert Decker
RR#, St. Address, Box # : R.R. #2
City, State, ZIP Code : Canton, KS.

Board of Agriculture, Division of Water Resources
Application Number:

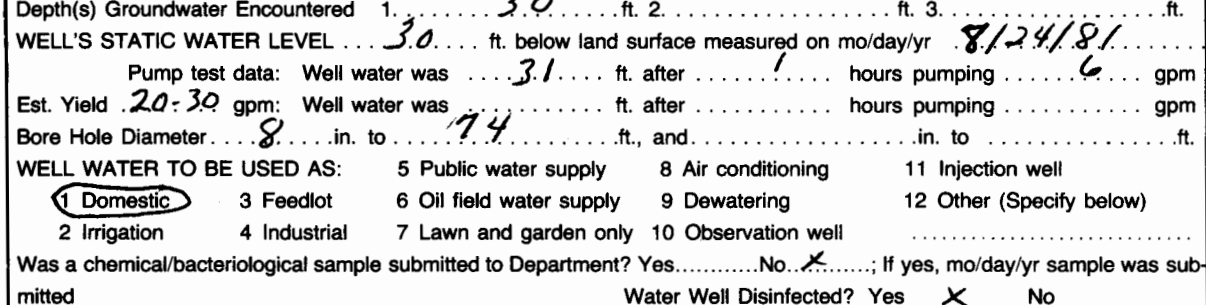

TYPE OF SCREEN OR PERFORATION MATERIAL:

SCREEN OR PERFORATION OPENINGS ARE:

SCREEN-PERFORATED INTERVALS:	From 53	ft. to 63	ft., From	ft. to	ft.
	From	ft. to	ft., From	ft. to	ft.
GRAVEL PACK INTERVALS:	From 63	ft. to 15	ft., From	ft. to	ft.
	From	ft. to	ft., From	ft. to	ft.

What is the nearest source of possible contamination:

Direction from well? East

7 CONTRACTOR'S OR LANDOWNER'S CERTIFICATION: This water well was (1) constructed, (2) reconstructed, or (3) plugged under my jurisdiction and was

under the business name of PETERSON IRRIGATION INC. by (signature) Mike Peterson

INSTRUCTIONS: Use typewriter or ball point pen, PLEASE PRESS FIRMLY and PRINT clearly. Please fill in blanks, underline or circle the correct answers. Send top three copies to Kansas Department of Health and Environment, Division of Environment, Environmental Geology Section, Topeka, KS 66620. Send one to WATER WELL OWNER and retain one for your records.