

1 LOCATION OF WATER WELL: County: McPherson	Fraction SW 1/4 SW 1/4 SE 1/4	Section Number 34	Township Number T 19 S	Range Number R 1 E/W
---	---	-----------------------------	----------------------------------	--------------------------------

Distance and direction from nearest town or city street address of well if located within city?

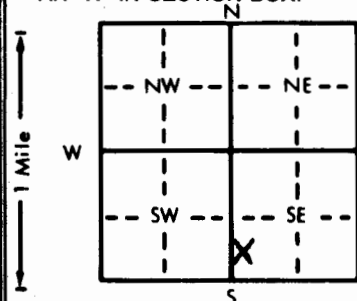
2 Mi. South 1/2 East Canton, Ks.2 WATER WELL OWNER: **Kermit Schmidt**RR#, St. Address, Box # : **Rt. 2**

Board of Agriculture, Division of Water Resources

City, State, ZIP Code : **Canton, Ks 67428**

Application Number:

3 LOCATE WELL'S LOCATION WITH AN "X" IN SECTION BOX:

4 DEPTH OF COMPLETED WELL: **67** ft. ELEVATION:Depth(s) Groundwater Encountered 1. **34** ft. 2. ft. 3. ft.
WELL'S STATIC WATER LEVEL **34** ft. below land surface measured on mo/day/yr **6/13/85**Pump test data: Well water was ft. after hours pumping gpm
Est. Yield **25-30** gpm: Well water was **6** ft. after **1 1/2** hours pumping **15** gpm
Bore Hole Diameter **8** in. to **67** ft., and in. to ft.WELL WATER TO BE USED AS: 5 Public water supply 8 Air conditioning 11 Injection well
1 Domestic 3 Feedlot 6 Oil field water supply 9 Dewatering 12 Other (Specify below)
2 Irrigation 4 Industrial 7 Lawn and garden only 10 Observation wellWas a chemical/bacteriological sample submitted to Department? Yes.....No **X**.....; If yes, mo/day/yr sample was submitted
Water Well Disinfected? Yes **X** No

5 TYPE OF BLANK CASING USED:

5 Wrought iron

8 Concrete tile

CASING JOINTS: Glued **X** Clamped

1 Steel

3 RMP (SR)

6 Asbestos-Cement

9 Other (specify below)

Welded

2 PVC

4 ABS

7 Fiberglass

Threaded

Blank casing diameter **5** in. to **56** ft., Dia. in. to ft., Dia. in. to ft.
Casing height above land surface **12** in., weight **2.91** lbs./ft. Wall thickness or gauge No. **265**

TYPE OF SCREEN OR PERFORATION MATERIAL:

1 Steel

3 Stainless steel

5 Fiberglass

7 PVC

10 Asbestos-cement

2 Brass

4 Galvanized steel

6 Concrete tile

8 RMP (SR)

11 Other (specify)

9 ABS

12 None used (open hole)

SCREEN OR PERFORATION OPENINGS ARE:

1 Continuous slot

3 Mill slot

5 Gauzed wrapped

8 Saw cut

11 None (open hole)

2 Louvered shutter

4 Key punched

6 Wire wrapped

9 Drilled holes

7 Torch cut

10 Other (specify)

SCREEN-PERFORATED INTERVALS: From **56** ft. to **67** ft., From ft. to ft.
From ft. to ft., From ft. to ft.GRAVEL PACK INTERVALS: From **15** ft. to **67** ft., From ft. to ft.
From ft. to ft., From ft. to ft.

6 GROUT MATERIAL:

1 Neat cement

2 Cement grout

3 Bentonite

4 Other

Grout Intervals: From **5** ft. to **15** ft., From ft. to ft., From ft. to ft.

What is the nearest source of possible contamination:

1 Septic tank

4 Lateral lines

7 Pit privy

10 Livestock pens

14 Abandoned water well

2 Sewer lines

5 Cess pool

8 Sewage lagoon

11 Fuel storage

15 Oil well/Gas well

3 Watertight sewer lines 6 Seepage pit

9 Feedyard

12 Fertilizer storage

16 Other (specify below)

13 Insecticide storage

Direction from well? **NORTH**How many feet? **150 ft**

FROM	TO	LITHOLOGIC LOG	FROM	TO	LITHOLOGIC LOG
0	4	Top Soil			
4	9	Clay-Pink			
9	18	Clay-Grey			
18	22	Clay- Buff			
22	28	Sand-v. Fine			
28	43	Clay-Pink			
43	50	Clay-W/Small Layers of F/Sand			
50	59	Clay-Some Fine Sand			
59	66	Sand- Very Fine			
66	67	Shale-Grey			

7 CONTRACTOR'S OR LANDOWNER'S CERTIFICATION: This water well was (1) constructed, (2) reconstructed, or (3) plugged under my jurisdiction and was completed on (mo/day/year) **6-13-85** and this record is true to the best of my knowledge and belief. KansasWater Well Contractor's License No. **138** This Water Well Record was completed on (mo/day/yr) **6-30-85**
under the business name of **Peterson Irrigation, Inc.** by (signature) *Mike Peterson*

INSTRUCTIONS: Use typewriter or ball point pen, PLEASE PRESS FIRMLY and PRINT clearly. Please fill in blanks, underline or circle the correct answers. Send top three copies to Kansas Department of Health and Environment, Division of Environment, Environmental Geology Section, Topeka, KS 66620. Send one to WATER WELL OWNER and retain one for your records.