


1 LOCATION OF WATER WELL: Fraction NW 1/4 NE 1/4 NE 1/4 Section Number 7 Township Number T 19 S Range Number R 1 ~~E~~W

Distance and direction from nearest town or city street address of well if located within city?
 2 miles North & 2 1/4 miles West of Canton, KS

2 WATER WELL OWNER: John Lubbers
 RR#, St. Address, Box # : 434 Lynns Lane Board of Agriculture, Division of Water Resources
 City, State, ZIP Code : McPherson, KS 67460 Application Number: N/A

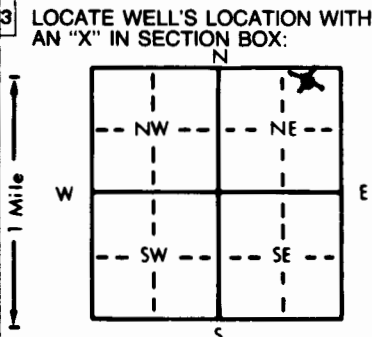

4 DEPTH OF COMPLETED WELL: 55 ft. ELEVATION:
 Depth(s) Groundwater Encountered 1. ft. 2. ft. 3. ft.
 WELL'S STATIC WATER LEVEL . . . 34 ft. below land surface measured on mo/day/yr . . . 8/25/98
 Pump test data: Well water was ft. after hours pumping gpm
 Est. Yield . . . 5-10 . . . gpm: Well water was ft. after hours pumping gpm
 Bore Hole Diameter . . . 8 in. to . . . 55 ft., and in. to ft.
 WELL WATER TO BE USED AS: 5 Public water supply 8 Air conditioning 11 Injection well
 Domestic 3 Feedlot 6 Oil field water supply 9 Dewatering 12 Other (Specify below)
 2 Irrigation 4 Industrial 7 Lawn and garden only 10 Monitoring well
 Was a chemical/bacteriological sample submitted to Department? Yes No X; If yes, mo/day/yr sample was submitted
 Water Well Disinfected? Yes X No

5 TYPE OF BLANK CASING USED: 5 Wrought iron 8 Concrete tile CASING JOINTS: Glued X Clamped
 1 Steel 3 RMP (SR) 6 Asbestos-Cement 9 Other (specify below) Welded
 PVC 4 ABS 7 Fiberglass Threaded
 Blank casing diameter in. to . . . 45 ft., Dia in. to ft., Dia in. to ft.
 Casing height above land surface . . . 12 in., weight . . . 2.37 lbs./ft. Wall thickness or gauge No. . . . 2.14
 TYPE OF SCREEN OR PERFORATION MATERIAL: PVC 10 Asbestos-cement
 1 Steel 3 Stainless steel 5 Fiberglass 8 RMP (SR) 11 Other (specify)
 2 Brass 4 Galvanized steel 6 Concrete tile 9 ABS 12 None used (open hole)
 SCREEN OR PERFORATION OPENINGS ARE: 5 Gauzed wrapped 8 Saw cut 11 None (open hole)
 1 Continuous slot Mill slot 6 Wire wrapped 9 Drilled holes
 2 Louvered shutter 4 Key punched 7 Torch cut 10 Other (specify)
 SCREEN-PERFORATED INTERVALS: From . . . 45 ft. to . . . 55 ft., From ft. to ft.
 From ft. to ft., From ft. to ft.
 GRAVEL PACK INTERVALS: From . . . 20 ft. to . . . 55 ft., From ft. to ft.
 From ft. to ft., From ft. to ft.

6 GROUT MATERIAL: 1 Neat cement 2 Cement grout Bentonite 4 Other
 Grout Intervals: From . . . 0 ft. to . . . 20 ft., From ft. to ft., From ft. to ft.
 What is the nearest source of possible contamination: 10 Livestock pens 14 Abandoned water well
 1 Septic tank Lateral lines 7 Pit privy 11 Fuel storage 15 Oil well/Gas well
 2 Sewer lines 5 Cess pool 8 Sewage lagoon 12 Fertilizer storage 16 Other (specify below)
 3 Watertight sewer lines 6 Seepage pit 9 Feedyard 13 Insecticide storage
 Direction from well? East How many feet? 600

FROM	TO	LITHOLOGIC LOG	FROM	TO	PLUGGING INTERVALS
0	2	Top Soil			
2	20	Brown Clay			
20	30	Fine Tan Sand			
30	46	Red & Green Sandy Clay			
46	55	Fine, Tan Sand with some sandy clay layers			
55		Green Shale			

7 CONTRACTOR'S OR LANDOWNER'S CERTIFICATION: This water well was constructed, (2) reconstructed, or (3) plugged under my jurisdiction and was completed on (mo/day/year) . . . 8/25/98 and this record is true to the best of my knowledge and belief. Kansas Water Well Contractor's License No. . . . 138 This Water Well Record was completed on (mo/day/yr) . . . 9/9/98 under the business name of Peterson Irrigation, Inc. by (signature) Mike Peterson