

USE TYPEWRITER OR BALL POINT PEN-PRESS FIRMLY, PRINT CLEARLY.

T R EW sec 1/4 1/4 1/4 No.


WATER WELL RECORD  
KSA 82a-1201-1215

Kansas State Dept. Of Health  
(Water Well Contractors)  
Forbes-Bldg, 740  
Topeka, Kansas 66620

*NW Corner of SW 1/4 SW 1/4*

1 Location of well: County McPherson Township name Canton Fraction \_\_\_\_\_ Section number 8 Town number T-19-5 Range number R-1-W

Distance and direction from nearest town or city: 2 Wm Hwy 56 3 Owner of well: Charon Koehn  
Street address of well location if in city: 244 N. Eastside Address: R.P. 1 - Canton, Ks. 67428

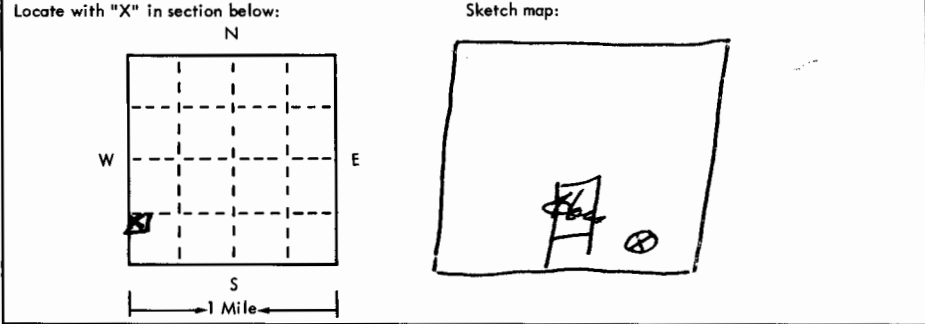

4 Well depth: 60 ft. Date of completion 9-5-75  
Well diameter 8" in.

5  Cable tool  Rotary  Driven  Dug  
 Hollow rod  Jetted  Bored  Reverse rotary

6 Use:  Domestic  Public supply  Industry  
 Irrigation  Air conditioning  Commercial  
 Test well

7 Casing: Material PVC Height: above below  
Threaded  Welded  Surface 12 in.  
Diam. 5" in. to 60 ft. depth Weight \_\_\_\_\_ lbs./ft. \_\_\_\_\_  
\_\_\_\_\_ in. to \_\_\_\_\_ ft. depth Drive shoe?  Yes  No

2	Type and color of material	From	To
	<u>Top Soil</u>	<u>0</u>	<u>4</u>
	<u>dark clay</u>	<u>4</u>	<u>8</u>
	<u>Gray Clay</u>	<u>8</u>	<u>17</u>
	<u>Very fine sands &amp; Clay lenses</u>	<u>17</u>	<u>21</u>
	<u>fine to med sands - clay</u>	<u>21</u>	<u>24</u>
	<u>White Clay &amp; Lime rock</u>	<u>24</u>	<u>40</u>
	<u>Gray Clay &amp; Lime rock</u>	<u>40</u>	<u>43</u>
	<u>fine sands</u>	<u>43</u>	<u>45</u>
	<u>fine to med sands - lime</u>	<u>45</u>	<u>57</u>
	<u>Blue Clay</u>	<u>57</u>	<u>60</u>

8 Screen: Manufacturer Canton Lead  
Type PVC Dia. 5"  
Slot gauge 1/32 Length 20ft  
Set between 40 ft. and 60 ft.  
Fittings: 1/2 - 1/4  
Gravel pack  Yes  No Size range of material \_\_\_\_\_

9 Static water level: 35 ft. below land surface Date 9-5-75

10 Pumping level below land surfaces:  
35 ft. after 2 hrs. pumping 15 g.p.m.  
\_\_\_\_\_ ft. after \_\_\_\_\_ hrs. pumping \_\_\_\_\_ g.p.m.  
Estimated maximum yield 30 g.p.m.

11 Water sample submitted:  
 Yes  No Date \_\_\_\_\_

12 Well head completion: 12"  
 Pitless adapter  Inches above grade

13 Well grouted?  Yes  No  
 Neat cement  Bentonite  \_\_\_\_\_  
Depth: From 0 ft. to 10 ft.

14 Nearest source of possible contamination:  
ft. 700 Direction North Type Septic  
Well disinfected upon completion?  Yes  No

15 Pump:  Not installed  
Manufacturer's name \_\_\_\_\_  
Model number \_\_\_\_\_ HP \_\_\_\_\_ Volts \_\_\_\_\_  
Length of drop pipe \_\_\_\_\_ ft. capacity \_\_\_\_\_ g.m.p.  
Type:  
 Submersible  Turbine  
 Jet  Reciprocating  
 Centrifugal  Other

16 Remarks: elevation

Topography:  
 Hill  
 Slope  
 Upland  
 Valley

The area around well slopes  
drains off to East & North

17 Water well contractor's certification:  
This well was drilled under my jurisdiction and this report is true to the best of my knowledge and belief.  
Peterson Bros FNC 138  
Business name License No.  
Address Box 152, Lindsborg KAN 67456  
Signed Wallaufstuen Date 9-6-75  
Authorized representative