

WATER WELL PLUGGING RECORD Form WWC-5P

KSA 82a-1212

ID NO.

18,756


1 LOCATION OF WATER WELL: County: McPherson Fraction Near Center NW 1/4 Section Number 32 Township Number 19 Range Number 1 ☒ W

Distance and direction from nearest town or city street address of well if located within city?

1 1/2 mi. West & 1 1/4 mi. South of Canton, KS

2 WATER WELL OWNER: City of Canton, KS Global Positioning Systems (decimal degrees, min. of 4 digits)
 RR#, St. Address, Box #: C/O Schwab-Eaton
 City, State ZIP Code: 101 S. Mill St. Beloit, KS 67420
 Latitude: _____
 Longitude: _____
 Elevation: _____
 Datum: _____
 Data Collection Method: _____

3 MARK WELL'S LOCATION WITH AN "X" IN SECTION BOX:

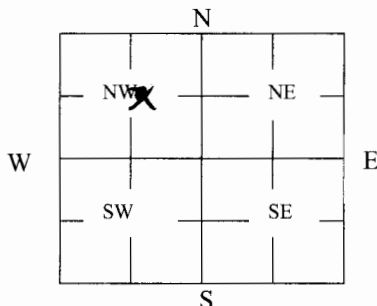

4 DEPTH OF WELL 104 ft.

WELL'S STATIC WATER LEVEL 42' ft

WELL WAS USED AS:

- | | | |
|--------------|----------------------------|-------------------|
| 1 Domestic | <u>Public Water Supply</u> | 9 Dewatering |
| 2 Irrigation | 6 Oil Field Water Supply | 10 Monitoring |
| 3 Feedlot | 7 Domestic (Lawn & Garden) | 11 Injection Well |
| 4 Industrial | 8 Air Conditioning | 12 Other _____ |

Was a chemical/bacteriological sample submitted to Department? Yes _____ No _____

5 TYPE OF BLANK CASING USED:

- | | | | | |
|----------------|------------|-------------------|-----------------|-------------------------|
| <u>1 Steel</u> | 3 RMP (SR) | 5 Wrought | 7 Fiberglass | 9 Other (Specify below) |
| 2 PVC | 4 ABS | 6 Asbestos-Cement | 8 Concrete Tile | |

Blank casing diameter 12 in. Was casing pulled? Yes _____ No X If yes, how much _____
 Casing height above or below land surface 14 in.

6 GROUT PLUG MATERIAL: 1 Neat cement 2 Cement grout 3 Bentonite 4 Other _____

Grout Plug Intervals: From 6 ft. to 44 ft., From 6 ft. to +1 ft., From _____ to _____ ft.

What is the nearest source of possible contamination:

- | | | | |
|--------------------------|-------------------|-------------------------|--|
| 1 Septic tank | 6 Seepage pit | 11 Fuel Storage | 16 Other (specify below) |
| 2 Sewer lines | 7 Pit privy | 12 Fertilizer storage | <u>NONE</u> |
| 3 Watertight sewer lines | 8 Sewage lagoon | 13 Insecticide storage | |
| 4 Lateral lines | 9 Feedyard | 14 Abandoned water well | Direction from well? <u>within 1/2</u> |
| 5 Cess pool | 10 Livestock pens | 15 Oil well/Gas well | How many feet? <u>mile</u> |

FROM	TO	PLUGGING MATERIALS	FROM	TO	PLUGGING MATERIALS
<u>44</u>	<u>104</u>	<u>Chlorinated sand & gravel</u>			
<u>6</u>	<u>44</u>	<u>Concrete</u>			
<u>+1</u>	<u>6</u>	<u>Bentonite</u>			
	<u>+1</u>	<u>Concrete cap</u>			
		<u>WAIVER GRANTED</u>			
		<u>9-4-2009</u>			

7 CONTRACTOR'S OR LANDOWNER'S CERTIFICATION: This water well was plugged under my jurisdiction and was completed on (mo/day/year) 10-4-09 and this record is true to the best of my knowledge and belief. Kansas Water Well Contractor's License No. 138. This Water Well Record was completed on (mo/day/year) 10-14-09 under the business name of Peterson Irrigation by (signature) Mike Peterson

INSTRUCTIONS: Use typewriter or ballpoint pen. Please press firmly and print clearly. Please fill in blanks, underline or circle the correct answers. Send top three copies to Kansas Department of Health and Environment, Bureau of Water, Geology Section, 1000 SW Jackson St., Ste. 420, Topeka, Kansas 66612-1367. Telephone: 785/296-5522. Send one to Water Well Owner and retain one for your records. Visit us at <http://www.kdheks.gov/geo/waterwells>.