

County: McPherson Fraction: E2, E2, SW, SE Sec. 6 T. 19 S R. 1 W

CORRECTION(S) to WATER WELL COMPLETION RECORD Form WWC-5 (to rectify lacking or incorrect information)

Owner: Glenn W. Voth

If location corrected, was listed as:

Section-Township-Range: _____

Fraction (1/4 calls): SE

Location changed to:

E2, E2, SW, SE

Other changes: Initial statements: Insufficient location description provided.

Changed to: 1.5 mile W of Canton, KS, to 25th Ave, 2 miles N to Navajo Rd, 1/4 mi W and 1/8 mi N.
Lat. 38.422164 deg N, Long. -97.468892 deg W (Google Earth WGS84).

Comments: Confirmed location with relative of owner (Matthew Voth) while viewing Google Earth.

Verification method: Used Google Earth and STR Finder.

Initials: PKC Date: 9/2/2021

Submitted by: Kansas Geological Survey, Data Resources Library, 1930 Constant Ave., Lawrence, KS 66047-3724

Kansas Dept. of Health & Environment, Bureau of Water, 1000 SW Jackson, Suite 420, Topeka, KS 66612-1367

Sand To KOTE

WATER WELL PLUGGING RECORD Form WWC-5P KSA 82a-1212 ID NO.


1 **LOCATION OF WATER WELL:** Fraction SE 1/4 1/4 1/4 Section Number 6 Township Number T 19 S Range Number 1 E W
 County: McPherson

Street/Rural Address of Well Location; if unknown, distance & direction from nearest town or intersection: If at owner's address, check here From the corner of 25th & Navajo
1/4 west + the 1/8 north

Global Positioning Systems (GPS) information:
 Latitude: _____ (in decimal degrees)
 Longitude: _____ (in decimal degrees)
 Elevation: _____
 Horizontal Datum: WGS84, NAD83, NAD27
 Collection Method: _____

2 **WATER WELL OWNER:** Glenn W. Voth
 RR#, St. Address, Box #: 25 E 100 N
 City, State ZIP Code: Hyrum UT 84319

GPS unit (Make/Model): _____
 Digital Map/Photo, Topographic Map, Land Survey
 Est. Accuracy: < 3 m, 3-5 m, 5-15 m, > 15 m

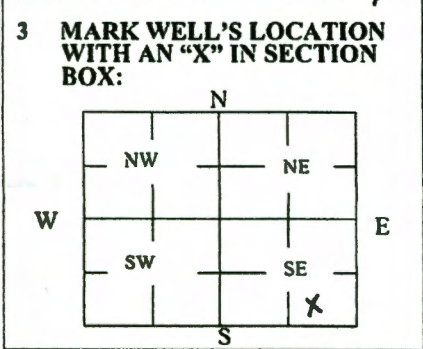

4 **DEPTH OF WELL** 50 ft.
WELL'S STATIC WATER LEVEL 38 ft
WELL WAS USED AS:
 Domestic Public Water Supply Dewatering
 Irrigation Oil Field Water Supply Monitoring
 Feedlot Domestic (Lawn & Garden) Injection Well
 Industrial Air Conditioning Other _____
 Was a chemical/bacteriological sample submitted to Department? Yes No

5 **TYPE OF BLANK CASING USED:**
 Steel RMP (SR) Wrought Fiberglass Other (Specify below)
 PVC ABS Asbestos-Cement Concrete Tile Sandstone
 Blank casing diameter 36 in. Was casing pulled? Yes No If yes, how much 5 feet
 Casing height above or below land surface 60 in.

6 **GROUT PLUG MATERIAL:** Neat cement Cement grout Bentonite Other _____
 Grout Plug Intervals: From 7 ft. to 5 ft., From _____ ft. to _____ ft., From _____ ft. to _____ ft.
 What is the nearest source of possible contamination:
 Septic tank Seepage pit Fuel storage Other (specify below)
 Sewer lines Pit privy Fertilizer storage
 Watertight sewer lines Sewage lagoon Insecticide storage
 Lateral lines Feedyard Abandoned water well
 Cess pool Livestock pens Oil well/Gas well
 Direction from well? East
 How many feet? 600 feet

FROM	TO	PLUGGING MATERIALS	FROM	TO	PLUGGING MATERIALS
32	50	Sand			
32	0	Soil (radius Bentonite plug)			

7 **CONTRACTOR'S OR LANDOWNER'S CERTIFICATION:** This water well was plugged under my jurisdiction and was completed on (mo/day/year) 8/10/2001 and this record is true to the best of my knowledge and belief. Kansas Water Well Contractor's License No. _____ This Water Well Record was completed on (mo/day/year) _____ under the business name of Matthew Voth by (signature) Matthew Voth

Send one white copy to Kansas Department of Health & Environment, Geology Section, 1000 SW Jackson Street, Ste. 420, Topeka, KS 66612-1367. Send one copy to WATER WELL OWNER and retain one for your records.
 Visit us at <http://www.kdheks.gov/waterwell/index.html> Telephone 785-296-5524.