


1 LOCATION OF WATER WELL: County: Rice Fraction NE 1/4 NE 1/4 SE 1/4 Section Number 24 Township Number T 19 S Range Number R 10 NW

Distance and direction from nearest town or city street address of well if located within city? Approximately 1 mile west and 2 1/4 miles north of Chase

2 WATER WELL OWNER: Cal-Maine Foods, Inc. RR#, St. Address, Box #: Box 347 City, State, ZIP Code: Buhler, KS 67522 Board of Agriculture, Division of Water Resources Application Number: 41,431

3 LOCATE WELL'S LOCATION WITH AN "X" IN SECTION BOX:

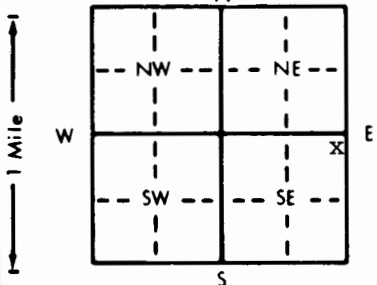

4 DEPTH OF COMPLETED WELL: 46 ft. ELEVATION: unknown

Depth(s) Groundwater Encountered 1. . . . . ft. 2. . . . . ft. 3. . . . . ft.  
 WELL'S STATIC WATER LEVEL 16 ft. below land surface measured on mo/day/yr  
 Pump test data: Well water was not ch'd. ft. after . . . . . hours pumping . . . . . gpm  
 Est. Yield unknown gpm: Well water was . . . . . ft. after . . . . . hours pumping . . . . . gpm  
 Bore Hole Diameter 18 in. to 50 ft. and . . . . . in. to . . . . . ft.  
 WELL WATER TO BE USED AS: 5 Public water supply 8 Air conditioning 11 Injection well  
 1 Domestic 3 Feedlot 6 Oil field water supply 9 Dewatering 12 Other (Specify below)  
 2 Irrigation 4 Industrial 7 Lawn and garden only 10 Monitoring well  
 Was a chemical/bacteriological sample submitted to Department? Yes . . . . . No . . . . . X . . . . . If yes, mo/day/yr sample was submitted  
 Water Well Disinfected? Yes . . . . . No . . . . . X . . . . .

5 TYPE OF BLANK CASING USED: 1 Steel 3 RMP (SR) 5 Wrought iron 8 Concrete tile CASING JOINTS: Glued . . . . . X . . . . . Clamped . . . . .  
 2 PVC 4 ABS 6 Asbestos-Cement 9 Other (specify below) Welded . . . . .  
 7 Fiberglass Threaded . . . . .

Blank casing diameter 8 5/8 in. to 39 ft. Dia . . . . . in. to . . . . . ft. Dia . . . . . in. to . . . . . ft.  
 Casing height above land surface 12 in. weight 5,54 lbs./ft. Wall thickness or gauge No. .322

TYPE OF SCREEN OR PERFORATION MATERIAL: 7 PVC 10 Asbestos-cement  
 1 Steel 3 Stainless steel 5 Fiberglass 8 RMP (SR) 11 Other (specify) . . . . .  
 2 Brass 4 Galvanized steel 6 Concrete tile 9 ABS 12 None used (open hole)

SCREEN OR PERFORATION OPENINGS ARE: 5 Gauzed wrapped 8 Saw cut 11 None (open hole)  
 1 Continuous slot 3 Mill slot 6 Wire wrapped 9 Drilled holes  
 2 Louvered shutter 4 Key punched 7 Torch cut 10 Other (specify) . . . . .

SCREEN-PERFORATED INTERVALS: From . . . . . 39 ft. to . . . . . 45 ft. From . . . . . ft. to . . . . . ft.  
 From . . . . . ft. to . . . . . ft. From . . . . . ft. to . . . . . ft.  
 GRAVEL PACK INTERVALS: From . . . . . 32 ft. to . . . . . 50 ft. From . . . . . ft. to . . . . . ft.  
 From . . . . . ft. to . . . . . ft. From . . . . . ft. to . . . . . ft.

6 GROUT MATERIAL: 1 Neat cement compacted clay 2 Cement grout 3 Bentonite 4 Other Bentonite Holeplug  
 Grout Intervals: From . . . . . 0 ft. to . . . . . 5 ft. From . . . . . 5 ft. to . . . . . 29 ft. From . . . . . 29 ft. to . . . . . 32 ft.

What is the nearest source of possible contamination:  
 1 Septic tank 4 Lateral lines 7 Pit privy 10 Livestock pens 14 Abandoned water well  
 2 Sewer lines 5 Cess pool 8 Sewage lagoon 11 Fuel storage 15 Oil well/Gas well  
 3 Watertight sewer lines 6 Seepage pit 9 Feedyard 12 Fertilizer storage 16 Other (specify below)  
 13 Insecticide storage . . . . . None known . . . . .

Direction from well? How many feet?

FROM	TO	LITHOLOGIC LOG	FROM	TO	PLUGGING INTERVALS
0	2	Topsoil			
2	9	Clay, gray			
9	15	Clay, brown			
15	23	Clay, tan			
23	31	Clay, white and gray			
31	34	Clay with fine sand			
34	38	Sandstone, very soft			
38	50	Sand and gravel, very fine, fine			

7 CONTRACTOR'S OR LANDOWNER'S CERTIFICATION: This water well was (1) constructed, (2) reconstructed, or (3) plugged under my jurisdiction and was completed on (mo/day/year) 11-15-96 and this record is true to the best of my knowledge and belief. Kansas Water Well Contractor's License No. 185 This Water Well Record was completed on (mo/day/yr) 11-19-96 under the business name of Clarke Well & Equipment, Inc. by (signature) Clarke Well & Equipment