


1 LOCATION OF WATER WELL: County: <b>Rice</b>	Fraction: <b>SE ¼ NE ¼ SE ¼</b>	Section Number: <b>3</b>	Township Number: <b>T 19 S</b>	Range Number: <b>R 10 E/W</b>
---	---------------------------------	--------------------------	--------------------------------	-------------------------------

Distance and direction from nearest town or city street address of well if located within city?  
**5 mi. N, 3 mi. W of Chase**

2 WATER WELL OWNER: National Cooperative Refinery Assoc. RR#, St. Address, Box # : 1391 Iron Horse Road City, State, ZIP Code : McPherson, KS 67460	Board of Agriculture, Division of Water Resources Application Number:
---	--

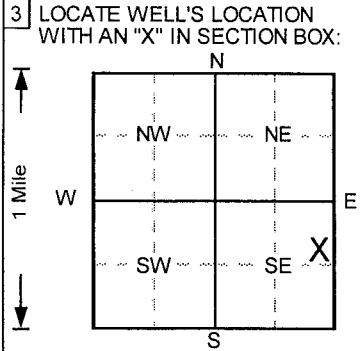

4 DEPTH OF COMPLETED WELL . . . . . 15 . . . . . ft. ELEVATION: . . . . .

Depth(s) Groundwater Encountered 1. . . . . 5.8 . . . . . ft. 2. . . . . ft. 3. . . . . ft.

WELL'S STATIC WATER LEVEL . . . . . 5.8 . . . . . ft. below land surface measured on mo/day/yr . . . . . 9/20/2005 . . . . .

Pump test data: Well water was . . . . . NA . . . . . ft. after . . . . . hours pumping . . . . . gpm

Est. Yield . . . . . NA . . . . . gpm: Well water was . . . . . ft. after . . . . . hours pumping . . . . . gpm

Bore Hole Diameter . . . . . 8 . . . . . in. to . . . . . 15 . . . . . ft., and . . . . . in. to . . . . . ft.

WELL WATER TO BE USED AS:

5 Public water supply	8 Air conditioning	11 Injection well
1 Domestic	3 Feedlot	6 Oil field water supply
2 Irrigation	4 Industrial	7 Lawn and garden only
		10 Monitoring well

Was a chemical/bacteriological sample submitted to Department? Yes.....No✓ ; If yes, mo/day/yr sample was submitted

Water Well Disinfectea? Yes No ✓

5 TYPE OF BLANK CASING USED:

1 Steel	3 RMP (SR)	5 Wrought iron	8 Concrete tile
2 PVC	4 ABS	6 Asbestos-Cement	9 Other (specify below)
		7 Fiberglass	

CASING JOINTS: Glued . . . . . Clamped . . . . .  
Welded . . . . .  
Threaded. ✓

Blank casing diameter . . . . . 2 . . . . . in. to . . . . . 5 . . . . . ft., Dia . . . . . in. to . . . . . ft., Dia . . . . . in. to . . . . . ft.

Casing height above land surface . . . . . 0 . . . . . in., weight . . . . . lbs./ft. Wall thickness or gauge No. . . . . Sch. 40

TYPE OF SCREEN OR PERFORATION MATERIAL

1 Steel	3 Stainless steel	5 Fiberglass	7 PVC	10 Asbestos-cement
2 Brass	4 Galvanized steel	6 Concrete tile	8 RMP (SR)	11 Other (specify) . . . . .
			9 ABS	12 None used (open hole)

SCREEN OR PERFORATION OPENINGS ARE:

1 Continuous slot	3 Mill slot	5 Gauzed wrapped	8 Saw cut	11 None (open hole)
2 Louvered shutter	4 Key punched	6 Wire wrapped	9 Drilled holes	
		7 Torch cut	10 Other (specify) . . . . .	

SCREEN-PERFORATED INTERVALS: From . . . . . 5 . . . . . ft. to . . . . . 15 . . . . . ft., From . . . . . ft. to . . . . . ft.  
From . . . . . ft. to . . . . . ft., From . . . . . ft. to . . . . . ft.

GRAVEL PACK INTERVALS: From . . . . . 4 . . . . . ft. to . . . . . 15 . . . . . ft., From . . . . . ft. to . . . . . ft.  
From . . . . . ft. to . . . . . ft., From . . . . . ft. to . . . . . ft.

6 GROUT MATERIAL: 1 Neat cement 2 Cement grout 3 Bentonite 4 Other . . . . .

Grout Intervals: From . . . . . 0 . . . . . ft. to . . . . . 1 . . . . . ft., From . . . . . 1 . . . . . ft. to . . . . . 4 . . . . . ft., From . . . . . ft. to . . . . . ft.

What is the nearest source of possible contamination:

1 Septic tank	4 Lateral lines	7 Pit privy	10 Livestock pens	14 Abandoned water well
2 Sewer lines	5 Cess pool	8 Sewage lagoon	11 Fuel storage	15 Oil well/Gas well
3 Watertight sewer lines	6 Seepage pit	9 Feedyard	12 Fertilizer storage	16 Other (specify below)
			13 Insecticide storage	

Direction from well? How many feet? 0

FROM	TO	LITHOLOGIC LOG	FROM	TO	PLUGGING INTERVALS
0	3	Clay, silty, damp, Dark Gray			
3	5	Clay, sandy, moist, Brown			
5	9	Sand, silty, moist, Tan			
9	15	Silt, sandy, saturated at 10', Tan			

MW1, Flushmount  
Project Name: Wilson - NCRA - Hoelscher  
GeoCore # 1245, #

7 CONTRACTOR'S OR LANDOWNER'S CERTIFICATION: This water well was (1) constructed, (2) reconstructed, or (3) plugged under my jurisdiction and was completed on (mo/day/year) . . . . . 9/19/2005 . . . . . and this record is true to the best of my knowledge and belief.  
Kansas Water Well Contractor's License No. . . . . 527 . . . . . This Water Well Record was completed on (mo/day/yr) . . . . . 9/26/2005 . . . . .  
under the business name of **GeoCore, Inc.** by (signature) *Dale Roloff*

INSTRUCTIONS: Use typewriter or ball point pen. PLEASE PRESS FIRMLY and PRINT clearly. Please fill in blanks, underline or circle the correct answers. Send top three copies to Kansas Department of Health and Environment, Bureau of Water, Topeka, Kansas 66620-0001. Telephone: 913-296-5545. Send one to WATER WELL OWNER and retain one for your records.