


1 LOCATION OF WATER WELL: Fraction Section Number Township Number Range Number  
 County: Rice NW 1/4 SW 1/4 NW 1/4 17 19 10 1/4

Distance and direction from nearest town or city street address of well if located within city?  
5 3/4 West, 3 North of Chase

2 WATER WELL OWNER: K & N Petroleum  
 RR #, St. Address, Box #: 513 E. 6th  
 City, State, ZIP Code : Ellinwood, Ks. 67526 Board of Agriculture, Division of Water Resources  
 Application Number: 20070438

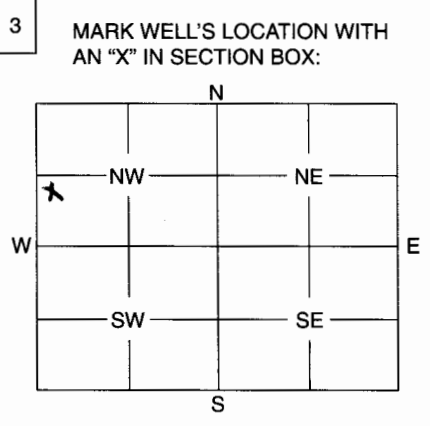

4 DEPTH OF WELL 75 ft.  
 WELL'S STATIC WATER LEVEL 10 ft.  
 WELL WAS USED AS:  
 1 Domestic 2 Irrigation 3 Feedlot 4 Industrial 5 Public Water Supply 6 Oil Field Water Supply 7 Domestic (Lawn & Garden) 8 Air Conditioning 9 Dewatering 10 Monitoring Well 11 Injection Well 12 Other .....

Was a chemical / bacteriological sample submitted to Department? Yes ..... No X.....  
 If yes, mo/day/yr sample was submitted .....

Water Well Disinfected: Yes HTH No .....

5 TYPE OF BLANK CASING USED:  
 1 Steel 2 PVC 3 RMP (SR) 4 ABS 5 Wrought 6 Asbestos-Cement 7 Fiberglass 8 Concrete Tile 9 Other (Specify below) .....

Blank casing diameter 5 in. Was casing pulled? Yes ..... No X..... If yes, how much .....

Casing height above or below land surface 36 in.

6 GROUT PLUG MATERIAL: 1 Neat cement 2 Cement grout 3 Bentonite 4 Other hole plug .....

Grout Plug Intervals: From ..... ft. to ..... ft., From ..... ft. to ..... ft., From 75 to 3 ft.

What is the nearest source of possible contamination:  
 1 Septic tank 2 Sewer lines 3 Watertight sewer lines 4 Lateral lines 5 Cess pool 6 Seepage pit 7 Pit privy 8 Sewage lagoon 9 Feedyard 10 Livestock pens 11 Fuel storage 12 Fertilizer storage 13 Insecticide storage 14 Abandoned water well 15 Oil well/Gas well 16 Other (specify below) None .....

Direction from well? ..... How many feet? .....

FROM	TO	PLUGGING MATERIALS
75	3	Hole plug
3	0	Top soil

7 CONTRACTOR'S OF LANDOWNER'S CERTIFICATION: This water well was plugged under my jurisdiction and was completed on (mo/day/year) 2-8-08 ..... and this record is true to the best of my knowledge and belief. Kansas Water Well Contractor's License No. 134 ..... This Water Well Record was completed on (mo/day/year) 2-11-08 ..... under the business name of Rosencrantz- Bemis .....  
 by (signature) [Signature] .....

INSTRUCTIONS: Use typewriter or ball point pen. Please press firmly and print clearly. Please fill in blanks, underline or circle the correct answers. Send top three copies to Kansas Department of Health and Environment, Bureau of Water, Geology Section, 1000 SW Jackson St., Ste. 420, Topeka, Kansas 66612-1367. Telephone: 785/296-5522. Send one to Water Well Owner and retain one for your records.