

WATER WELL RECORD

Form WWC-5


Division of Water Resources App. No.

1 LOCATION OF WATER WELL: County: Rice, Fraction: 1/4 SE 1/4 NW 1/4 SW 1/4, Section Number: 30, Township No.: T 19 S, Range Number: R 10

Street/Rural Address of Well Location; if unknown, distance & direction from nearest town or intersection: 6W, 1N of Chase, KS. Global Positioning System (GPS) information: Latitude, Longitude, Elevation, Datum, Collection Method.

2 WATER WELL OWNER: Dale Knop, RR#, Street Address, Box #: 1006 E. Santa Fe, City, State, ZIP Code: Ellinwood, KS 67526

GPS information: Datum: WGS 84, NAD 83, NAD 27. Collection Method: GPS unit, Digital Map/Photo, Topographic Map, Land Survey. Est. Accuracy: <3 m, 3-5 m, 5-15 m, >15 m

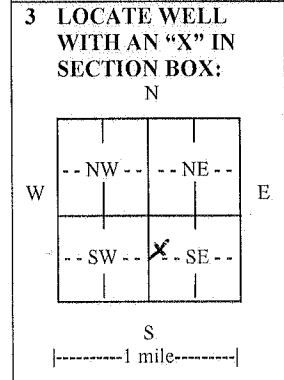

3 LOCATE WELL WITH AN 'X' IN SECTION BOX. 4 DEPTH OF COMPLETED WELL 113 ft. Depth(s) Groundwater Encountered (1) 16 ft. WELL'S STATIC WATER LEVEL 16 ft. below land surface measured on mo/day/yr. 06/26/13. Pump test data: Well water was ... ft. after ... hours pumping ... gpm. EST. YIELD 60 gpm. Well water was ... ft. after ... hours pumping ... gpm. Bore Hole Diameter ... in. to ... ft., and ... in. to ... ft. WELL WATER TO BE USED AS: Oil field water supply. Was a chemical/bacteriological sample submitted to Department? No. Water well disinfected? Yes.

5 TYPE OF CASING USED: PVC. CASING JOINTS: Glued. Casing diameter .5 in. to .73 ft., Diameter ... in. to ... ft., Casing height above land surface .12 in., Weight 2.8 lbs./ft., Wall thickness or gauge No. Sch. 40. TYPE OF SCREEN OR PERFORATION MATERIAL: PVC. SCREEN OR PERFORATION OPENINGS ARE: Saw cut. SCREEN-PERFORATED INTERVALS: From .73 ft. to .113 ft. GRAVEL PACK INTERVALS: From .23 ft. to .113 ft.

6 GROUT MATERIAL: Bentonite. Grout Intervals: From .0 ft. to .23 ft. What is the nearest source of possible contamination: Oil well/gas well. Direction from well North Northeast. Distance from well .115.

Table with columns: FROM, TO, LITHOLOGIC LOG, FROM, TO, LITHO. LOG (cont.) or PLUGGING INTERVALS. Rows include: 0-1 top soil, 1-33 clay, 33-35 shale, 35-110 sand rock, 110-113 shale. Plugging intervals: Knop 6-30, Sterling Drilling Company, P O Box 1006, Pratt, KS 67124.

7 CONTRACTOR'S OR LANDOWNER'S CERTIFICATION: This water well was constructed, reconstructed, or plugged under my jurisdiction and was completed on (mo/day/year) 06/26/13. Kansas Water Well Contractor's License No. 186. This Water Well Record was completed on (mo/day/year) 06/28/13 under the business name of Kelly's Water Well Service, Inc. by (signature) Kathleen L. Brad.

INSTRUCTIONS: Use typewriter or ball point pen. PLEASE PRESS FIRMLY and PRINT clearly. Please fill in blanks and check the correct answers. Send one copy to Kansas Department of Health and Environment, Bureau of Water, Geology Section, 1000 SW Jackson St., Suite 420, Topeka, Kansas 66612-1367. Telephone 785-296-5524. Send one copy to WATER WELL OWNER and retain one for your records. Include fee of \$5.00 for each constructed well. Visit us at http://www.kdheks.gov/waterwell/index.html